

Date
 C27
 10-17-68

MISSISSIPPI
 BOARD OF WATER COMMISSIONERS
 416 North State Street
 Jackson, Mississippi 39201

CODED

WATER WELL DRILLERS LOG

CODED

10-17 1968 Harris Bros Date
 date well completed firm name county well located

LANDOWNER: Morris Young

description of formations encountered

from

to

pto 3

Coldwater
 (mailing address)

top soil

0 15

pea gravel

15 35

clay + sand

35 35

coarse sand

35 100

WELL LOCATION:

sec. 12 T. 4 N. R. 6 E.
 4 1/2 miles NE of Independence
 (distance) (direction) (nearest town)

WELL PURPOSE: none
 (home, irrigation, municipal, industrial)

WELL COMPLETION DATA:

- (1) diameter (inches) 4
- (2) total depth (feet) 100
- (3) static water level (feet) 40 below top of ground
- (4) casing 4" (material) 93' (depth)
 4" (size) if telescope see back.
- (5) screen 7" 93' (length) (depth to top)
 008 Plaster (size) (material)
- (6) pump 3/4 7 (HP) (yield gpm)
 elec. (type power)
- (7) electric log NO (yes or no)

(organization running log)

(8) how well bottom plugged: back

DRILLERS REMARKS:


INDEX

MAR 13 1969

MISS. DE. OF
 WATER CONTROL

If well telescopes please sketch and show depths.

GROUND LEVEL

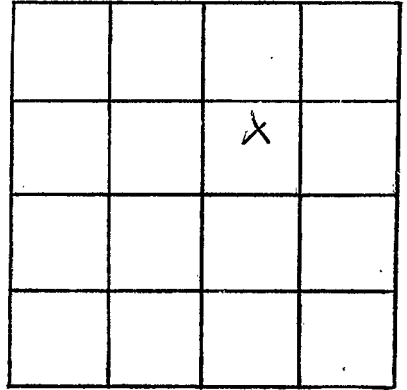

SECTION R2

Please indicate well location X.

ADDITIONAL INFORMATION

If more than one screen,
show locations of each on sketch.