

CODED
CODED

MISSISSIPPI
BOARD OF WATER COMMISSIONERS
416 North State Street
Jackson, Mississippi 39201

WATER WELL DRILLERS LOG

Late
C 29
11-8-68

11-8 1968 Harris Bros Late
date well completed firm name county well located

LANDOWNER: Hollis Massey

description of formations encountered	from	to
<u>top soil</u>	<u>0</u>	<u>20</u>
<u>sand</u>	<u>20</u>	<u>50</u>
<u>clay & sand</u>	<u>50</u>	<u>120</u>
<u>Coarse sand</u>	<u>120</u>	<u>150</u>

ste 3
Coldwater
(mailing address)

WELL LOCATION: SW SE
sec. 6 T. 4 N. R. 6 E
7 miles NW of Anderson
(distance) (direction) (nearest town)

WELL PURPOSE: home
(home, irrigation, municipal, industrial)

WELL COMPLETION DATA:

- (1) diameter (inches) 4
- (2) total depth (feet) 150'
- (3) static water level (feet) 80 ^{below} above top of ground.
- (4) casing Plastic 136'
(material) (depth)
4 If telescope see back.
(size)
- (5) screen 14" 136'
(length) (depth to top)
008 Plastic
(size) (material)
- (6) pump 1/2 25
(HP) (yield gpm)
Elec.
(type power)
- (7) electric log no
(yes or no)

(organization running log)

(8) how well bottom plugged brush


DRILLERS REMARKS:

MAR 13 1969

MISS. BD. OF
WATER COMM.

If well telescopes please sketch and show depths.

GROUND LEVEL

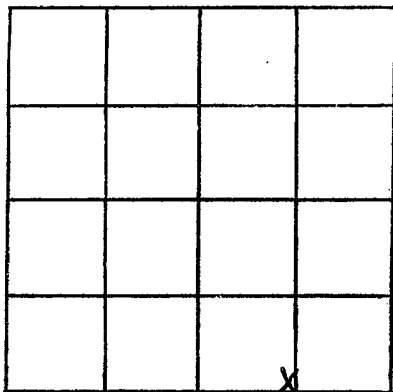

SECTION 6

Please indicate well location X.

ADDITIONAL INFORMATION

If more than one screen, show locations of each on sketch.