

CODED

CODED

MISSISSIPPI BOARD OF WATER COMMISSIONERS  
416 North State Street  
Jackson, Mississippi 39201

WATER WELL DRILLERS LOG

Date  
C 30  
11-29-68

11-29 1968 date well completed  
Harri Bow firm name  
Date county well located

LANDOWNER: W. B. Quonichet

description of formations encountered	from	to
top soil	0	20
sand	20	55
Clay	55	80
Clay & sand	80	135
Coarse sand	135	160

pte 3  
Caldwater  
(mailing address)

WELL LOCATION:  
sec. 30 T. 4 N. R. 6 E.  
6 miles (distance) E of Caldwater (nearest town)

WELL PURPOSE: none  
(home, irrigation, municipal, industrial)

WELL COMPLETION DATA:

- (1) diameter (inches) 4
- (2) total depth (feet) 160
- (3) static water level (feet) 100 below above top of ground.
- (4) casing Plastic, 14 1/2'  
(material) (depth)  
4 If telescope see back.  
(size)
- (5) screen 14" , 14 1/2'  
(length) (depth to top)  
008 Plastic  
(size) (material)
- (6) pump 3/4 7  
(HP) (yield gpm)  
Elec.  
(type power)
- (7) electric log no  
(yes or no)  
  
(organization running log)
- (8) how well bottom plugged back  
not

NO NEED


MAR 13 1969

DRILLERS REMARKS:

MISS. BD. OF WATER COMMISSIONERS

If well telescopes please sketch and show depths.

GROUND LEVEL

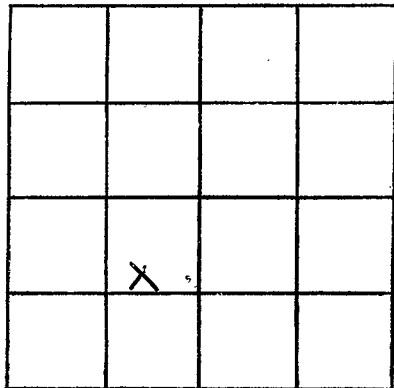

SECTION 30

Please indicate well location X.

ADDITIONAL INFORMATION

If more than one screen,  
show locations of each on sketch.