

Date
C 32
1-20-69

MISSISSIPPI
 BOARD OF WATER COMMISSIONERS
 416 North State Street
 Jackson, Mississippi 39201

CODE 2
 CODE 1

WATER WELL DRILLERS LOG

1-20 1969 Hannibury Zato
 date well completed firm name county well located

LANDOWNER: Jim Perryman
pte 2
Caldwater
 (mailing address)

description of formations encountered	from	to
<u>top soil</u>	<u>0</u>	<u>20</u>
<u>sand</u>	<u>20</u>	<u>60</u>
<u>clay</u>	<u>60</u>	<u>100</u>
<u>Indepense fine sand</u>	<u>100</u>	<u>110</u>
<u>Coarse sand</u>	<u>110</u>	<u>120</u>

WELL LOCATION:
 sec. 2 T. 4 N. R. 6 E.
6 miles N of Indepense
 (distance) (direction) (nearest town)

WELL PURPOSE: home
 (home, irrigation, municipal, industrial)

WELL COMPLETION DATA:
 (1) diameter (inches) 4
 (2) total depth (feet) 120
 (3) static water level (feet) 80 ^{below} _{above} top of ground.
 (4) casing Plastic 113'
 (material) (depth)
4 if telescope see back.
 (size)
 (5) screen 7' 113'
 (length) (depth to top)
008 Plastic
 (size) (material)
 (6) pump 3/4 10
 (HP) (yield gpm)
elec.
 (type power)
 (7) electric log no
 (yes or no)
 (organization running log)
 (8) how well bottom plugged brush
shot

INDEX


MAR 13 1969

DRILLERS REMARKS:

MISS. BD. OF
 WATER COMM.

If well telescopes please sketch and show depths.

GROUND LEVEL

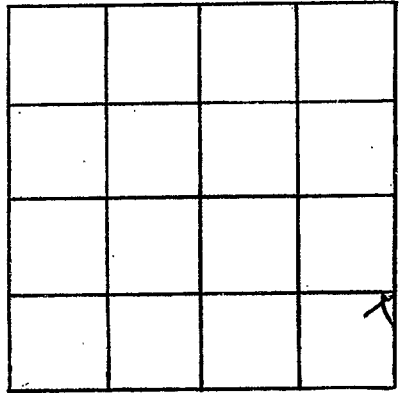

SECTION 2

Please indicate well location X.

ADDITIONAL INFORMATION

If more than one screen,
show locations of each on sketch.