

Tate  
C33  
2-3-69

MISSISSIPPI  
BOARD OF WATER COMMISSIONERS  
416 North State Street  
Jackson, Mississippi 39201

CODED.

WATER WELL DRILLERS LOG

CODED.

2-3 19 69 Harris Bros. Tate  
date well completed firm name county well located

LANDOWNER: E. S. Doney  
pto 3  
Coldwater  
(mailing address)

description of formations encountered	from	to
<u>top soil</u>	<u>0</u>	<u>20</u>
<u>red sand</u>	<u>20</u>	<u>40</u>
<u>clay + sand</u>	<u>40</u>	<u>80</u>
<u>independent sand</u>	<u>80</u>	<u>130</u>
<u>Coarse sand</u>	<u>130</u>	<u>140</u>

WELL LOCATION:  
sec 30 T 4 N R 6 E  
5 miles W of Independence  
(distance) (direction) (nearest town)

WELL PURPOSE: home  
(home, irrigation, municipal, industrial)

WELL COMPLETION DATA:

(1) diameter (inches) 4

(2) total depth (feet) 140

(3) static water level (feet) 80 below top of ground.

(4) casing Plastic 133  
(material) (depth)

4 If telescope see back.  
(size)

(5) screen 7', 133'  
(length) (depth to top)

008 Plastic  
(size) (material)

(6) pump 74 7  
(HP) (yield gpm)

elec.  
(type power)

(7) electric log no  
(yes or no)

(organization running log)

(8) how well bottom plugged back  
shot

LOG DATA


DRILLERS REMARKS:

MAR 13 1969

MISS. BD. OF  
WATER COMM.

If well telescopes please sketch and show depths.

GROUND LEVEL

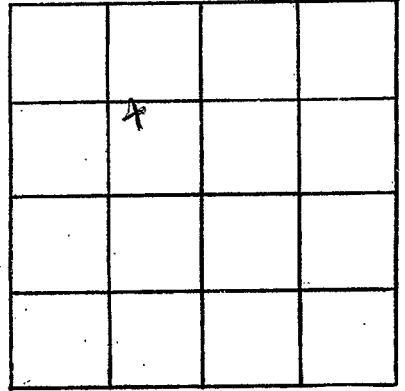

SECTION 30

Please indicate well location X.

ADDITIONAL INFORMATION

If more than one screen,  
show locations of each on sketch.