

MISSISSIPPI
BOARD OF WATER COMMISSIONERS
416 North State Street
Jackson, Mississippi 39201

Jate

WATER WELL DRILLERS LOG

Jate
C 35
2-28-69

date well completed *2-28-* 19 *69* firm name *Bob Smith Well Drilling* county well located *Madison*

LANDOWNER: *T. odd*

Callwater Miss
(mailing address)

WELL LOCATION:
sec. *10* T. *4* N. R. *6* E.
4 miles *NE* of *Indevence*
(distance) (direction) (nearest town)

description of formations encountered	from	to
<i>top soil</i>	<i>0</i>	<i>5</i>
<i>red clay</i>	<i>5</i>	<i>10</i>
<i>red gravel</i>	<i>10</i>	<i>20</i>
<i>white sand</i>	<i>30</i>	<i>50</i>
<i>gravel & sand</i>	<i>50</i>	<i>90</i>
<i>medium sand</i>	<i>90</i>	<i>160</i>

WELL PURPOSE: *home*
(home, irrigation, municipal, industrial)

- WELL COMPLETION DATA:
- (1) diameter (inches) *4*
- (2) total depth (feet) *160*
- (3) static water level (feet) *100* below above top of ground.
- (4) casing *Plastic 160*
(material) (depth)
(size) if telescope see back.
- (5) screen *20 140*
(length) (depth to top)
4 *Plastic*
(size) (material)
- (6) pump *1 10*
(HP) (yield gpm)
1 hp
(type power)
- (7) electric log *no*
(yes or no)
(organization running log)
- (8) how well bottom plugged *plugged*


MAY 23 1969

MISS. BD. OF
WATER COMM.

DRILLERS REMARKS:
~~...~~
had gravel

If well telescopes please sketch and show depths.

GROUND LEVEL

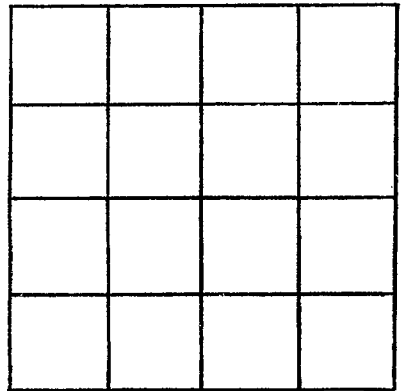

SECTION _____

Please indicate well location X.

ADDITIONAL INFORMATION

If more than one screen, show locations of each on sketch.