

Tate
C 42
7-69

MISSISSIPPI
BOARD OF WATER COMMISSIONERS
416 North State Street
Jackson, Mississippi 39201

WATER WELL DRILLERS LOG

7-58-1969 Bob Smith Tate
date well completed firm name county well located


LANDOWNER:	description of formations encountered	from	to
Green Leg med. Creek Independence, Miss. (mailing address)	top soil red clay red sand red gravel white sand white clay coarse sand	0 5 15 30 50 70 80	5 15 30 50 70 80 150
WELL LOCATION: sec. 9 T. 4 N. R. 2 E 6 miles N of Ind. (distance) (direction) (nearest town)			
WELL PURPOSE: (home, irrigation, municipal, industrial)			
WELL COMPLETION DATA: (1) diameter (inches) 4 (2) total depth (feet) 158 (3) static water level (feet) 100 below top of ground. (4) casing Plastic 158 (material) (depth) (size) if telescope see back. (5) screen 20 138 (length) (depth to top) 4 Plastic (size) (material) (6) pump 1/2 10 (HP) (yield gpm) 1/2 hp (type power) (7) electric log no (yes or no) (organization running log) (8) how well bottom plugged plugged			
DRILLERS REMARKS: good drilling			

AUG 11 1969

MISSISSIPPI
BOARD OF WATER COMMISSIONERS

If well telescopes please sketch and show depths.

GROUND LEVEL

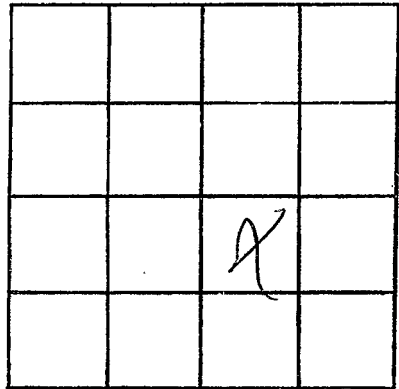

SECTION 9

Please indicate well location X.

ADDITIONAL INFORMATION

If more than one screen,
show locations of each on sketch.