

CODED

MISSISSIPPI BOARD OF WATER COMMISSIONERS
416 North State Street
Jackson, Mississippi 39201

SEP - 8 1969
MISS. DEPT. OF WATER CONTROL

WATER WELL DRILLERS LOG

Late
C43
8-28-69

August 28th. 1969
date well completed 19 W.A. MASON Water Well Contractor TATH CO.
firm name county well located

LANDOWNER: Robert Mayer
Route 5
Coldwater Miss.

(mailing address)

WELL LOCATION:
sec. 16 T. 4 N R. 5 E
1/2 miles SW of Wakarusa
(distance) (direction) (nearest town)

WELL PURPOSE:
(home, irrigation, municipal, industrial)


WELL COMPLETION DATA:
(1) diameter (inches) 12 in. Hole
(2) total depth (feet) 112
(3) static water level (feet) 90 below above top of ground.
(4) casing 5 in. Styrene plastic (material) 112 (depth)
If telescope see back.
(5) screen none (length) (depth to top)
(6) pump XXXXXX none (HP) (yield gpm)
(type power)
(7) electric log (yes or no)
(organization running log)
(8) how well bottom plugged not

| description of formations encountered | from | to |
|---------------------------------------|------|-----|
| HARD dirt | 0 | 12 |
| yellow hard sand | 12 | 15 |
| gravel | 15 | 17 |
| red sand & gravel | 17 | 25 |
| gravel | 25 | 27 |
| pink clay | 27 | 28 |
| yellow sand & gravel | 28 | 30 |
| yellowish sand | 30 | 40 |
| white sand & gravel | 40 | 57 |
| red clay | 57 | 60 |
| pink sand | 60 | 61 |
| white clay | 61 | 64 |
| gray sand | 64 | 70 |
| big gravel pecks | 70 | 75 |
| white sand | 75 | 80 |
| water bearing white fine sand | 80 | 100 |
| water bearing coarse sand & gravel | 100 | 110 |
| water bearing pea gravel | 110 | 112 |

DRILLERS REMARKS:

If well telescopes please sketch and show depths.

GROUND LEVEL

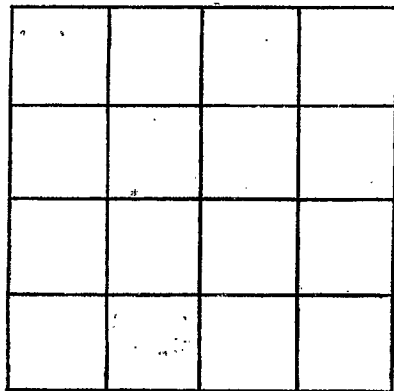

SECTION 16

Please indicate well location X.

ADDITIONAL INFORMATION

If more than one screen,
show locations of each on sketch.