

CODED

Tate, Co
C46
11-69

MISSISSIPPI
BOARD OF WATER COMMISSIONERS
416 North State Street
Jackson, Mississippi 39201
WATER WELL DRILLERS LOG


11-24 1969 Bob Smith Tate
date well completed firm name county well located

| LANDOWNER: | description of formations encountered | from | to |
|--|---------------------------------------|------|-----|
| Hunt | | | |
| Clodysburg, Miss. (mailing address) | red clay | 3 | 30 |
| WELL LOCATION: SW SE | red gravel | 30 | 50 |
| sec. 5 T. 4 N. R. 6 E. | white sand | 50 | 166 |
| 5 miles NW of Tnd | | | |
| (distance) (direction) (nearest town) | | | |
| WELL PURPOSE: Home | | | |
| (home, irrigation, municipal, industrial) | | | |
| WELL COMPLETION DATA: | | | |
| (1) diameter (inches) 4 | | | |
| (2) total depth (feet) 166 | | | |
| (3) static water level (feet) 110 below top of ground. | | | |
| (4) casing 166 (material) (depth) | | | |
| (size) If telescope see back. | | | |
| (5) screen 20 146 (length) (depth to top) | | | |
| (size) (material) | | | |
| (6) pump 1 20 (HP) (yield gpm) | | | |
| (type power) | | | |
| (7) electric log TW (yes or no) | | | |
| (organization running log) | | | |
| (8) how well bottom plugged plugged | | | |
| DRILLERS REMARKS: good drilling | | | |

MISS. HD. OF WATER CONTROL

If well telescopes please sketch and show depths.

GROUND LEVEL

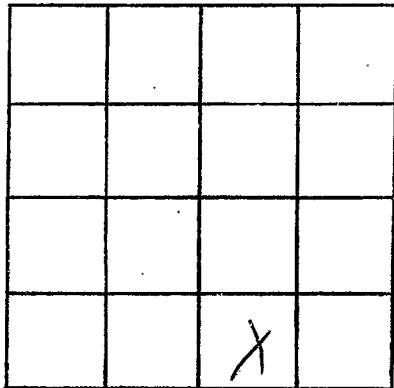

SECTION _____

Please indicate well location X.

ADDITIONAL INFORMATION

If more than one screen, show locations of each on sketch.