

TATE
C 47
3-22-69

MISSISSIPPI
BOARD OF WATER COMMISSIONERS
416 North State Street
Jackson, Mississippi 39201

CODED

WATER WELL DRILLERS LOG

3-22 1969 date well completed Harris Bros. firm name Tate county well located

LANDOWNER: Billy Randolph Moore
Rt 2 Coldwater
(mailing address)

description of formations encountered	from	to
top soil	0	65
red sand	15	40
white sand & clay	40	85
fine sand	85	125
coarse sand	125	140

WELL LOCATION:
sec. 18 T. 4 N. R. 6 E. (W)
3 miles NW of Independence
(distance) (direction) (nearest town)

WELL PURPOSE: none
(home, irrigation, municipal, industrial)

WELL COMPLETION DATA:

(1) diameter (inches) 4"

(2) total depth (feet) 140

(3) static water level (feet) 90 below top of ground.

(4) casing Plastic, 133'
(material) (depth)
4" if telescope see back.
(size)

(5) screen 7', 133'
(length) (depth to top)
008, Plastic
(size) (material)

(6) pump 3/4 7
(HP) (yield gpm)
elec
(type power)

(7) electric log no
(yes or no)

(organization running log)


(8) how well bottom plugged back
not

DRILLERS REMARKS:

DEC 22 1969
MISS. Bd. of
WATER COMMISSIONERS

If well telescopes please sketch and show depths.

GROUND LEVEL

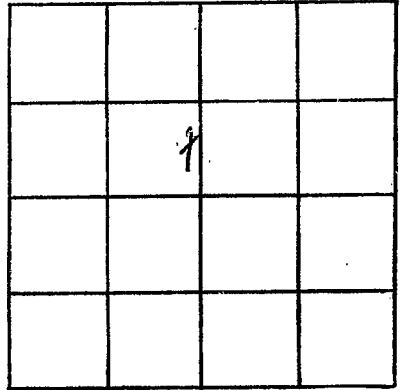

SECTION 18

Please indicate well location X.

ADDITIONAL INFORMATION

If more than one screen,
show locations of each on sketch.