

Date  
 C 48  
 3-25-69

MISSISSIPPI  
 BOARD OF WATER COMMISSIONERS  
 416 North State Street  
 Jackson, Mississippi 39201

CODED

WATER WELL DRILLERS LOG

3-25 1969 Harris Bros. Tate  
 date well completed firm name county well located

LANDOWNER: Harley Smith  
 pte 2  
 Coldwater  
 (mailing address)

description of formations encountered	from	to
top soil	0	20
white clay	20	45
clay and sand	45	90
coarse sand	90	100

WELL LOCATION:  
 sec 29 T 4 N R 6 E S 3 W  
 2.9 miles of Independence  
 (distance) (direction) (nearest town)

WELL PURPOSE: home  
 (home, irrigation, municipal, industrial)

WELL COMPLETION DATA:

(1) diameter (inches) 4

(2) total depth (feet) 100

(3) static water level (feet) 60 <sup>below</sup> top of ground.

(4) casing Plastic 93' (material) (depth)  
 4" (size) If telescope see back.

(5) screen 7' 93' (length) (depth to top)  
 .008 Plastic (size) (material)

(6) pump 3/4 10 (HP) (yield gpm)  
 elec. (type power)

(7) electric log no (yes or no)

(organization running log)


(8) how well bottom plugged back  
 shut

DRILLERS REMARKS:

REC 29 1969  
 MISS. Bd. OF WATER COMM.

If well telescopes please sketch and show depths.

GROUND LEVEL

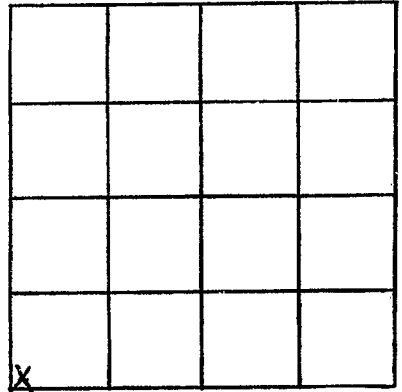

SECTION 20

Please indicate well location X.

ADDITIONAL INFORMATION

If more than one screen, show locations of each on sketch.