

CODED

MISSISSIPPI
BOARD OF WATER COMMISSIONERS
416 North State Street
Jackson, Mississippi 39201

WATER WELL DRILLERS LOG

TATE
C 49
3-28-69

3-28 1969 date well completed
Harris Bros. firm name
Lute county well located

LANDOWNER: W. W. Walker
Rto 2
Coldwater
(mailing address)

description of formations encountered	from	to
top soil	0	20
red sand	20	40
clay + sand	40	85
course sand	85	100

WELL LOCATION:
sec 34 T 4 N R 6 E
1/4 miles S of Independence
(distance) (direction) (nearest town)

WELL PURPOSE: ~~for~~ municipal
(home, irrigation, municipal, industrial)

WELL COMPLETION DATA:

(1) diameter (inches) 4

(2) total depth (feet) 100

(3) static water level (feet) 100 ^{below}/_{above} top of ground.

(4) casing Plastic 93'
(material) (depth)
4 (size) If telescope see back.

(5) screen 7' 93'
(length) (depth to top)
008 Plastic
(size) (material)

(6) pump 3/4 7
(HP) (yield gpm)
elec.
(type power)

(7) electric log no
(yes or no)

(organization running log)

(8) how well bottom plugged much
smt


DRILLERS REMARKS:

DEC 22 1969

MISS. BD. OF
WATER COMMISSIONERS

If well telescopes please sketch and show depths.

GROUND LEVEL

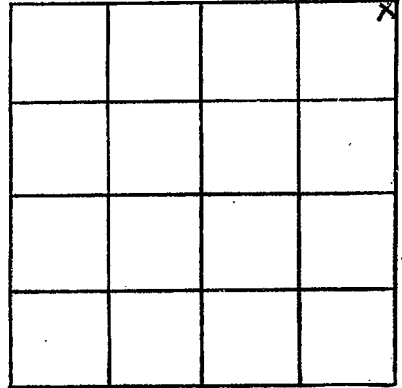

SECTION 24

Please indicate well location X.

ADDITIONAL INFORMATION

If more than one screen,
show locations of each on sketch.