

TATE
 C 53
 6-15-69

MISSISSIPPI
 BOARD OF WATER COMMISSIONERS
 416 North State Street
 Jackson, Mississippi 39201

CODED

WATER WELL DRILLERS LOG

6-15 1969 date well completed
 Harris Bros. firm name
 Tate county well located

LANDOWNER: Bobby F. Lowrie
 Rte 3
 Caldwellwater
 (mailing address)

description of formations encountered	from	to
top soil	0	25
clay	25	60
clay + sand	60	85
coarse sand	85	100

WELL LOCATION:
 sec. 13 T 4 N R 6 E
 7 1/2 miles NE of Andalus
 (distance) (direction) (nearest town)

WELL PURPOSE: home
 (home, irrigation, municipal, industrial)


- WELL COMPLETION DATA:
- (1) diameter (inches) 4"
 - (2) total depth (feet) 100
 - (3) static water level (feet) 60 (below top of ground)
 - (4) casing Plastic, 93" (material), (depth)
 4" (size) if telescope see back.
 - (5) screen 7' (length), 93" (depth to top)
 #008 Plastic (size) (material)
 - (6) pump 3/4 (HP), 10 (yield gpm)
 elec. (type power)
 - (7) electric log no (yes or no)
 - (organization running log)
 - (8) how well bottom plugged back shot

DRILLERS REMARKS:

DEC 22 1969
 MISS. BO. OF WATER COMMISSIONERS

If well telescopes please sketch and show depths.

GROUND LEVEL

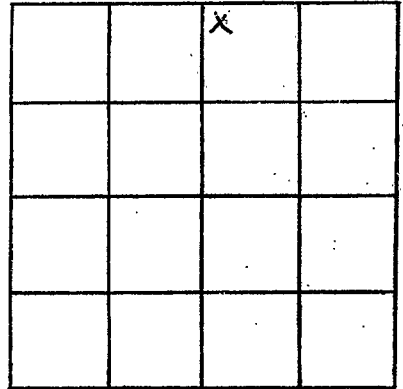

SECTION _____

Please indicate well location X.

ADDITIONAL INFORMATION

If more than one screen, show locations of each on sketch.