

TATE
C 54
6-25-69

MISSISSIPPI
BOARD OF WATER COMMISSIONERS
416 North State Street
Jackson, Mississippi 39201

CODED

WATER WELL DRILLERS LOG

6-25 1969 Harris Bros. Tate
date well completed firm name county well located


LANDOWNER	description of formations encountered	from	to
Annie & Coleman pte. 3 Coldwater (mailing address)	top soil	0	20
WELL LOCATION: sec. 7 T. 4 N. R. 7 E. 7 miles NW of Osprey (distance) (direction) (nearest town)	flg gravel + sand	20	65
WELL PURPOSE: none (home, irrigation, municipal, industrial)	white clay + sand	65	120
WELL COMPLETION DATA:	coarse sand	120	140
(1) diameter (inches) 4"			
(2) total depth (feet) 140			
(3) static water level (feet) 100 <small>below above</small> top of ground.			
(4) casing Plastic, 133' (material) (depth)			
4" if telescope see back. (size)			
(5) screen 7', 133' (length) (depth to top)			
.008, Plastic (size) (material)			
(6) pump 3/4 7 (HP) (yield gpm)			
electric (type power)			
(7) electric log No (yes or no)			
(organization running log)			
(8) how well bottom plugged shut			
DRILLERS REMARKS:			

DEC 22 1969

MISS. BD. OF
WATER COMMISSIONERS

If well telescopes please sketch and show depths.

GROUND LEVEL

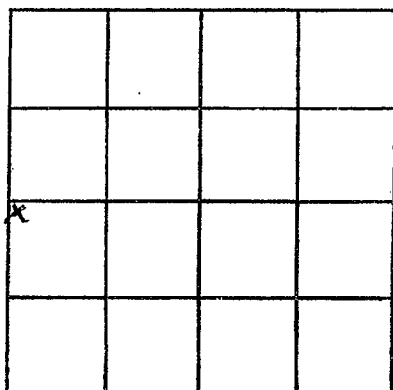

SECTION 7

Please indicate well location X.

ADDITIONAL INFORMATION

If more than one screen, show locations of each on sketch.