

TATE  
C 55  
7-8-69

MISSISSIPPI  
BOARD OF WATER COMMISSIONERS  
416 North State Street  
Jackson, Mississippi 39201

CODED

WATER WELL DRILLERS LOG

7-8 1969 date well completed  
Harris Bros firm name  
Tate county well located

LANDOWNER: L.B. Sewette

description of formations encountered

from to

pte 2  
Coldwater

top soil	0	20
gravel + red sand	20	50
clayt sand	50	95
coarse sand	95	110

(mailing address)

WELL LOCATION:

sec 27 T 4 N R 6 E  
3/4 miles W of Clarks  
(distance) (direction) (nearest town)

WELL PURPOSE: home  
(home, irrigation, municipal, industrial)

WELL COMPLETION DATA:

- diameter (inches) 4
- total depth (feet) 110
- static water level (feet) 600 below top of ground.
- casing (material) Plastic, 103' (depth)  
4" (size) if telescope see back.
- screen (length) 7' (depth to top) 103'  
208' Plastic (size) (material)
- pump 3/4 (HP) 7 (yield gpm)  
elec. (type power)
- electric log no (yes or no)

(organization running log)


(8) how well bottom plugged back

DRILLERS REMARKS:

DEC 22 1969  
MISS. Bd. of WATER COMMISSIONERS

If well telescopes please sketch and show depths.

GROUND LEVEL

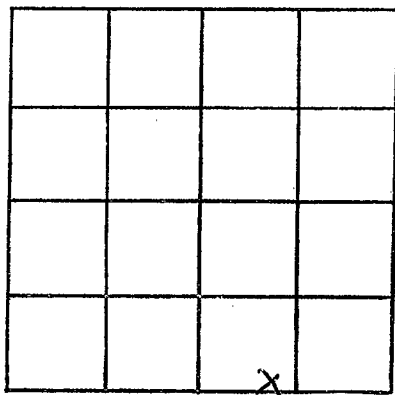

SECTION 27

Please indicate well location X.

ADDITIONAL INFORMATION

If more than one screen, show locations of each on sketch.