

TATE
 C56
 7-10-69

MISSISSIPPI
 BOARD OF WATER COMMISSIONERS
 416 North State Street
 Jackson, Mississippi 39201

CODED

WATER WELL DRILLERS LOG

7-10 1969 date well completed
 Harris Bros. firm name
 Tate county well located

LANDOWNER: Seland Algee

description of formations encountered

from to

Rte. 3

Coldwater
 (mailing address)

top soil 0 15

red sand 15 65

WELL LOCATION:

sect 6 T 4 N R 6 E
6 miles NW of Clondrop
 (distance) (direction) (nearest town)

white clay 65 95

clay + sand 95 110

WELL PURPOSE: none
 (home, irrigation, municipal, industrial)

coarse sand 110 120

WELL COMPLETION DATA:

- (1) diameter (inches) 4"
- (2) total depth (feet) 120
- (3) static water level (feet) 80 below above top of ground.
- (4) casing Plastic 113'
 (material) (depth)
4"
 (size) If telescope see back.
- (5) screen 7' 113'
 (length) (depth to top)
008 Plastic
 (size) (material)
- (6) pump 3/4 7
 (HP) (yield gpm)
elec.
 (type power)
- (7) electric log no
 (yes or no)

(organization running log)


(8) how well bottom plugged back shot

DRILLERS REMARKS:

DEC 22 1969
 MISS. BD. OF
 WATER COMMISSIONERS

If well telescopes please sketch and show depths.

GROUND LEVEL

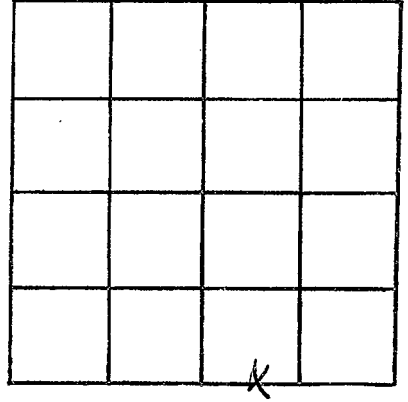

SECTION 116

Please indicate well location X.

ADDITIONAL INFORMATION

If more than one screen, show locations of each on sketch.