

MISSISSIPPI  
BOARD OF WATER COMMISSIONERS  
416 North State Street  
Jackson, Mississippi 39201

CODED

WATER WELL DRILLERS LOG

TATE
C 57
8-10-69

8-10 1969 date well completed      Harris Bros. Tate firm name      county well located


LANDOWNER	description of formations encountered	from	to
Mrs. R. E. Barber Rte. 3 Coldwater (mailing address)	top soil	0	20
WELL LOCATION: sec. 28 T 4 N R 6 E 1 miles W of Independence (distance) (direction) (nearest town)	clay + sand	20	90
WELL PURPOSE: none (home, irrigation, municipal, industrial)	Coarse sand	90	100
WELL COMPLETION DATA: (1) diameter (inches) 4" (2) total depth (feet) 100 (3) static water level (feet) 60 <u>below</u> top of ground. (4) casing Plastic 43' (material) (depth) 4" (size) if telescope see back. (5) screen 7' 93' (length) (depth to top) 008 Plastic (size) (material) (6) pump 3/4 7 (HP) (yield gpm) elec. (type power) (7) electric log no (yes or no)  (organization running log)			
(8) how well bottom plugged w/rock spot			
DRILLERS REMARKS:			

DEC 22 1969

MISS. BD. OF  
WATER COM'RS

If well telescopes please sketch and show depths.

GROUND LEVEL

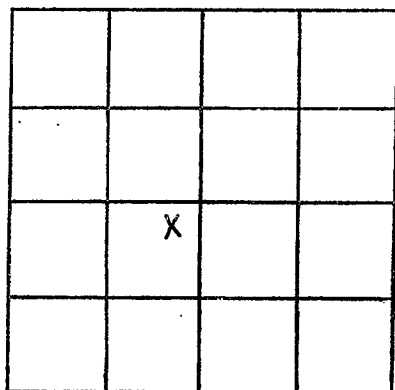

SECTION 28

Please indicate well location X.

ADDITIONAL INFORMATION

If more than one screen, show locations of each on sketch.