

TATE

C 59

9-10-69

MISSISSIPPI
 BOARD OF WATER COMMISSIONERS
 416 North State Street
 Jackson, Mississippi 39201

CODED

WATER WELL DRILLERS LOG

9-10
date well completed

1969 Harrison Bros. Tate
firm name county well located

LANDOWNER: Billy Maxwell

description of formations encountered

from to

rte 2 x

Caldwate

(mailing address)

top soil

0 15

red sand

15 65

clay + sand

65 90

coarse sand

90 100

WELL LOCATION:

sec 26 T 4 N R 6 E
 1 miles E of Independence
 (distance) (direction) (nearest town)

WELL PURPOSE: none
(home, irrigation, municipal, industrial)

WELL COMPLETION DATA:

- (1) diameter (inches) 4"
- (2) total depth (feet) 100'
- (3) static water level (feet) 10' below top of ground
- (4) casing Plastic 4" (material) 93' (depth)
If telescope see back.
- (5) screen 7' 93' (length) (depth to top)
008 Plastic (size) (material)
- (6) pump 3/4 HP 10 (HP) (yield gpm)
elec. (type power)
- (7) electric log no (yes or no)

(organization running log)

(8) how well bottom plugged back shot


DRILLERS REMARKS:

DEC 20 1969

MISS. BD. OF WATER COMMISSIONERS

If well telescopes please sketch and show depths.

GROUND LEVEL

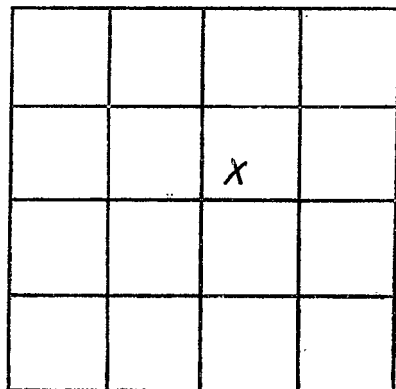

SECTION _____

Please indicate well location X.

ADDITIONAL INFORMATION

If more than one screen, show locations of each on sketch.