

CODED

MISSISSIPPI  
BOARD OF WATER COMMISSIONERS  
416 North State Street  
Jackson, Mississippi 39201

WATER WELL DRILLERS LOG

FATE
C 60
9-20-69

9-20 1969 Harris Bros. Tate  
 date well completed firm name county well located


LANDOWNER: <u>S. J. South</u> <u>pte. 2</u> <u>Coldwater</u> (mailing address)	description of formations encountered	from	to
	<u>top soil</u>	<u>0</u>	<u>15</u>
	<u>red sand</u>	<u>15</u>	<u>40</u>
	<u>clay + sand</u>	<u>40</u>	<u>90</u>
	<u>coarse sand</u>	<u>90</u>	<u>100</u>
WELL LOCATION: sec. <u>32</u> T <u>4</u> N R. <u>6</u> E <u>2</u> miles <u>W</u> of <u>condemned</u> (distance) (direction) (nearest town)			
WELL PURPOSE: <u>home</u> (home, irrigation, municipal, industrial)			
WELL COMPLETION DATA: (1) diameter (inches) <u>4</u> (2) total depth (feet) <u>100</u> (3) static water level (feet) <u>60</u> <u>below</u> above top of ground. (4) casing <u>Plastic</u> , <u>93'</u> (material) (depth) <u>4'</u> if telescope see back. (size) (5) screen <u>7'</u> , <u>93</u> (length) (depth to top) <u>000 Plastic</u> (size) (material) (6) pump <u>3/4</u> <u>7</u> (HP) (yield gpm) <u>etc.</u> (type power) (7) electric log <u>no</u> (yes or no) <u>(organization running log)</u> (8) how well bottom plugged <u>brush</u> <u>short</u>			
DRILLERS REMARKS:			

DEC 29 1969

MISS. BD. OF  
WATER COMM.

If well telescopes please sketch and show depths.

GROUND LEVEL

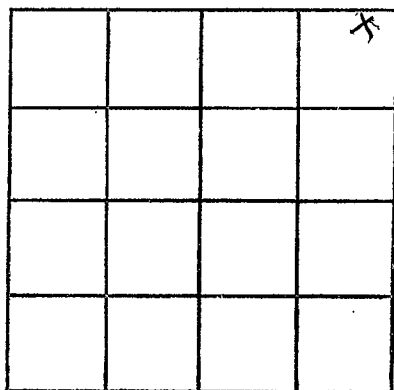

SECTION 32

Please indicate well location X.

ADDITIONAL INFORMATION

If more than one screen,  
show locations of each on sketch.