

TATE
 C 61
 10-1-69

MISSISSIPPI
 BOARD OF WATER COMMISSIONERS
 416 North State Street
 Jackson, Mississippi 39201

WATER WELL DRILLERS LOG

10-1-1969 date well completed
 Harris Bros. Tate firm name
 county well located

LANDOWNER: Homer Avery
Independence
 (mailing address)
 WELL LOCATION:
 sec 26 T 4 N R 6 E
Independence
 (distance) (direction) (nearest town)

description of formations encountered	from	to
<u>top soil</u>	<u>0</u>	<u>1.5</u>
<u>clay + sand</u>	<u>1.5</u>	<u>8.5</u>
<u>coarse sand</u>	<u>8.5</u>	<u>100</u>

WELL PURPOSE: none
 (home, irrigation, municipal, industrial)

WELL COMPLETION DATA:

(1) diameter (inches) 4

(2) total depth (feet) 100

(3) static water level (feet) 60 below above top of ground.

(4) casing Plastic 93'
 (material) (depth)
4 if telescope see back.
 (size)

(5) screen 7' 93'
 (length) (depth to top)
008 Plastic
 (size) (material)

(6) pump 3/4 7
 (HP) (yield gpm)
elec.
 (type power)

(7) electric log No
 (yes or no)

(organization running log)

(8) how well bottom plugged back
shot


DEC 29 1969

MISS. BD. OF
 WATER COMMISSIONERS

DRILLERS REMARKS:

If well telescopes please sketch and show depths.

GROUND LEVEL

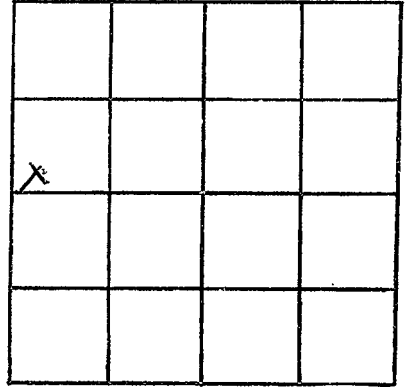

SECTION 26

Please indicate well location X.

ADDITIONAL INFORMATION

If more than one screen,
show locations of each on sketch.