

CODED

MISSISSIPPI
BOARD OF WATER COMMISSIONERS
416 North State Street
Jackson, Mississippi 39201

WATER WELL DRILLERS LOG

TATE
C 62
11-1-69

11-1 1969 Harris Bros. Tate
 date well completed firm name county well located

LANDOWNER: Carl Greenwood

description of formations encountered

from to

pte 2

Coldwater

(mailing address)

top soil

0 15

clay sand

15 90

course sand

90 100

WELL LOCATION:

sec. 14 T 4 N R 6 E
 6 1/2 miles NW of Independence
 (distance) (direction) (nearest town)

WELL PURPOSE: none
(home, irrigation, municipal, industrial)

WELL COMPLETION DATA:

- (1) diameter (inches) 4
- (2) total depth (feet) 100'
- (3) static water level (feet) 60' ^{below} top of ground.
- (4) casing Plastic, 93'
(material) (depth)
4" (size) if telescope see back.
- (5) screen 7' 93'
(length) (depth to top)
1/2" Plastic
(size) (material)
- (6) pump 3/4 7
(HP) (yield gpm)
elec.
(type power)
- (7) electric log no
(yes or no)

(organization running log)

(8) how well bottom plugged back
not


DRILLERS REMARKS:

DEC 29 1969

MISS. DE. OF
WATER COMM.

If well telescopes please sketch and show depths.

GROUND LEVEL

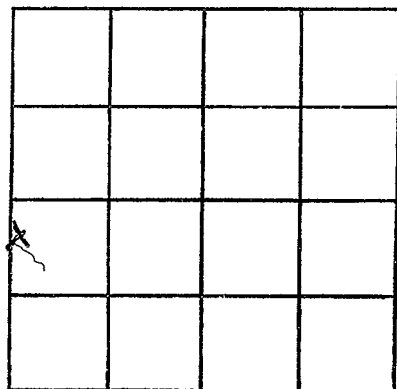

SECTION 10

Please indicate well location X.

ADDITIONAL INFORMATION

If more than one screen, show locations of each on sketch.