

TATE  
 C63  
 1-14-70

MISSISSIPPI  
 BOARD OF WATER COMMISSIONERS  
 416 North State Street  
 Jackson, Mississippi 39201

CODED


WATER WELL DRILLERS LOG

1-14 1970 Harris Bros. Tate  
 date well completed firm name county well located

LANDOWNER: Claude Leung Rt. 2	description of formations encountered	from	to
Coldwater (mailing address)	top soil	0	20
WELL LOCATION: sec 34 T 4 N R 6 E 3/4 miles West of Anderson (distance) (direction) (nearest town)	clay + fine sand	20	80
WELL PURPOSE: home (home, irrigation, municipal, industrial)	coarse sand	80	100
WELL COMPLETION DATA: (1) diameter (inches) 4 (2) total depth (feet) 100 (3) static water level (feet) 60 <input checked="" type="checkbox"/> below <input type="checkbox"/> above top of ground. (4) casing Plastic, 9.3' (material) (depth) 4" (size) if telescope see back. (5) screen 7' (length), 93' (depth to top) #008, Plastic (size) (material) (6) pump 3/4 (HP), 7 (yield gpm) Elec. (type power) (7) electric log no (yes or no) (organization running log) (8) how well bottom plugged back shut			
DRILLERS REMARKS:	FEB 18 1970 MISS. BD. OF WATER COMMISSIONERS		

If well telescopes please sketch and show depths.

GROUND LEVEL

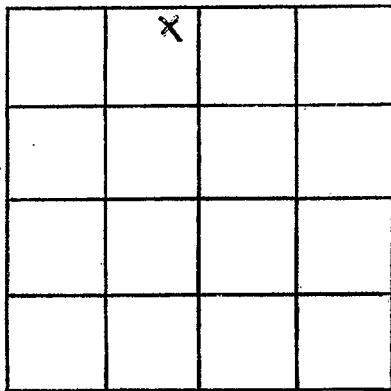

SECTION 34

Please indicate well location X.

ADDITIONAL INFORMATION

If more than one screen, show locations of each on sketch.