

Tate
 C 65
 12-24-69

MISSISSIPPI
 BOARD OF WATER COMMISSIONERS
 416 North State Street
 Jackson, Mississippi 39201
 WATER WELL DRILLERS LOG

CODED

12-24 1969 date well completed Bob Smith firm name Tate county well located

LANDOWNER: Hudson
Chadwick, Miss.
 (mailing address)

description of formations encountered	from	to
Top sand	0	5
red sand	5	12
white clay	12	40
Orange sand	40	40

WELL LOCATION:
 sec 22 T 4 N R 6 E
1 1/2 miles north of Indp.
 (distance) (direction) (nearest town)

WELL PURPOSE: None
 (home, irrigation, municipal, industrial)

- WELL COMPLETION DATA:
- (1) diameter (inches) 4
 - (2) total depth (feet) 140
 - (3) static water level (feet) 100 below above top of ground.
 - (4) casing Plastic 140
 (material) (depth)
 (size) If telescope see back.
 - (5) screen 20 120
 (length) (depth to top)
4 Plastic
 (size) (material)
 - (6) pump 7 1/2 15
 (HP) (yield gpm)
Electric
 (type power)
 - (7) electric log no
 (yes or no)
 (organization running log)
 - (8) how well bottom plugged plugged

CODED


MAR 13 1970

MISS. BD. OF
 WATER COMMISSIONERS

DRILLERS REMARKS:
good drilling

If well telescopes please sketch and show depths.

GROUND LEVEL

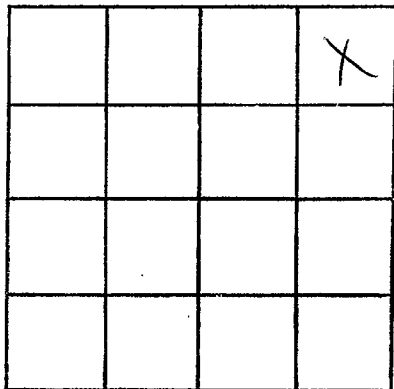

SECTION _____

Please indicate well location X.

ADDITIONAL INFORMATION

If more than one screen,
show locations of each on sketch.