

CODED

Tate  
C 66  
12-29-69

MISSISSIPPI  
BOARD OF WATER COMMISSIONERS  
416 North State Street  
Jackson, Mississippi 39201

WATER WELL DRILLERS LOG

12-29-1969 Bob Smith Tate  
date well completed firm name county well located

LANDOWNER:	description of formations encountered:	from	to
Q. my Hunt Independence, Miss. (mailing address)			
	red clay	5	20
	dravel	20	30
	dark fine	30	50
	white clay	50	70
	fine sand	70	110
	coarse sand	110	170

WELL LOCATION:  
sec. 5 T. 4 N. R. 6 SE-NE  
8 miles north Indp.  
(distance) (direction) (nearest town)

WELL PURPOSE: Home  
(home, irrigation, municipal, industrial)

- WELL COMPLETION DATA:
- (1) diameter (inches) 4
  - (2) total depth (feet) 170
  - (3) static water level (feet) 100 below top of ground.
  - (4) casing Plastic, 170 (material) (depth)
  - (size) if telescope see back.
  - (5) screen 20 150 (length) (depth to top)
  - (size) 4 Plastic (material)
  - (6) pump 3/4 15 (HP) (yield gpm)
  - (type power) Elec.
  - (7) electric log no (yes or no)
  - (organization running log)
  - (8) how well bottom plugged plugged

CODED


MAR 13 1970

MISS. BD. OF  
WATER COMM.

DRILLERS REMARKS:  
good drilling

If well telescopes please sketch and show depths.

GROUND LEVEL

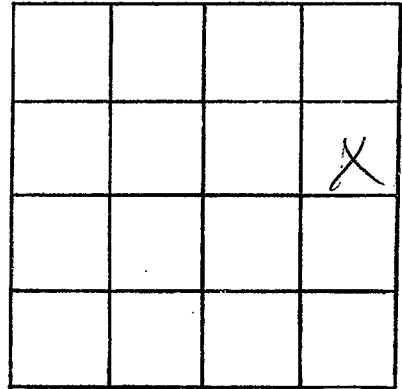

SECTION \_\_\_\_\_

Please indicate well location X.

ADDITIONAL INFORMATION

If more than one screen,  
show locations of each on sketch.