

**MISSISSIPPI  
BOARD OF WATER COMMISSIONERS  
416 North State Street  
Jackson, Mississippi 39201**

**Tate Co**  
**C 69**  
**4-3-70**

**3 AB WATER WELL DRILLERS LOG**

4-3 1970 Harris Bros Tate  
date well completed firm name county well located

LANDOWNER: Zellie Purgan  
Rt. 2  
Coldwater  
(mailing address)

WELL LOCATION:  
sec. 32 T 4 N R 6 E 100  
2 3/4 miles N of Andersen  
(distance) (direction) (nearest town)

description of formations encountered	from	to
<u>top soil</u>	<u>0</u>	<u>20</u>
<u>sand + clay</u>	<u>20</u>	<u>60</u>
<u>fine sand</u>	<u>60</u>	<u>95</u>
<u>Coarse sand</u>	<u>95</u>	<u>120</u>

WELL PURPOSE: None  
(home, irrigation, municipal, industrial)

WELL COMPLETION DATA:

(1) diameter (inches) 4"

(2) total depth (feet) 120'

(3) static water level (feet) 80 (below) above top of ground.

(4) casing P. plastic, 106"  
(material) (depth)  
4" if telescope see back.  
(size)

(5) screen 14", 106'  
(length) (depth to top)  
.008, P. plastic  
(size) (material)

(6) pump 1, 15  
(HP) (yield gpm)  
elec  
(type power)

(7) electric log no  
(yes or no)

(organization running log)

(8) how well bottom plugged brack  
and


DRILLERS REMARKS:

JUN 17 1970

MISS. REG. OFF.  
WATER CONTROL

If well telescopes please sketch and show depths.

GROUND LEVEL

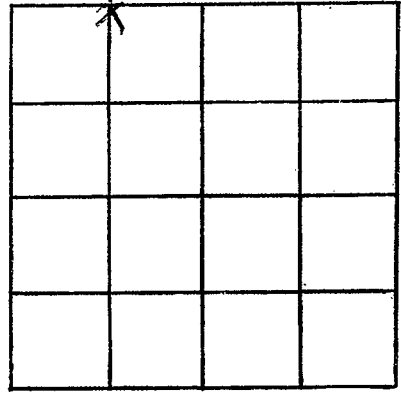

SECTION 32

Please indicate well location X.

ADDITIONAL INFORMATION

Lined area for additional information.

If more than one screen, show locations of each on sketch.