

Tate
 C 70
 5-10-70
 3 AA

MISSISSIPPI
 BOARD OF WATER COMMISSIONERS
 416 North State Street
 Jackson, Mississippi 39201

WATER WELL DRILLERS LOG

5-10 1970 Harris Bros Tate
 date well completed firm name county well located


LANDOWNER: <u>Ralph Williams</u>	description of formations encountered	from	to
<u>Rt. 2</u> <u>Coldwater</u> (mailing address)			
WELL LOCATION: <u>100</u> sec <u>20</u> T <u>4</u> N R <u>6</u> E <u>3</u> miles <u>NW</u> of <u>Independence</u> (distance) (direction) (nearest town)	<u>top soil</u>	<u>0</u>	<u>15</u>
WELL PURPOSE: <u>home</u> (home, irrigation, municipal, industrial)	<u>clay + sand</u>	<u>15</u>	<u>75</u>
WELL COMPLETION DATA:	<u>Coarse sand</u>	<u>75</u>	<u>100</u>
(1) diameter (inches) <u>4</u>			
(2) total depth (feet) <u>100</u>			
(3) static water level (feet) <u>40</u> <u>below</u> above top of ground.			
(4) casing <u>Plastic</u> , <u>86</u> (material) (depth)			
<u>4</u> If telescope see back. (dizo)			
(5) screen <u>14'</u> , <u>86"</u> (length) (depth to top)			
<u>008</u> , <u>Plastic</u> (size) (material)			
(6) pump <u>1</u> , <u>15</u> (HP) (yield gpm)			
<u>elec.</u> (type power)			
(7) electric log <u>no</u> (yes or no)			
(organization running log)			
(8) how well bottom plugged <u>back</u> <u>snats</u>			
DRILLERS REMARKS:			

JUN 17 1970

MISS. BD. OF
 WATER COMM.

If well telescopes please sketch and show depths.

GROUND LEVEL

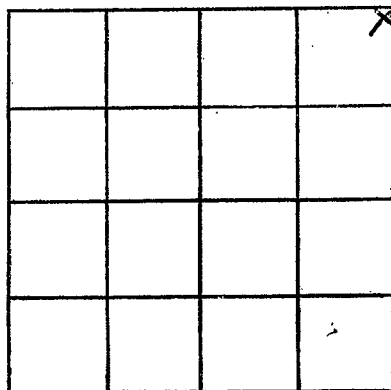

SECTION 20

Please indicate well location X.

ADDITIONAL INFORMATION

If more than one screen, show locations of each on sketch.