

MISSISSIPPI
BOARD OF WATER COMMISSIONERS
416 North State Street
Jackson, Mississippi 39201

Tate Co
C 71
5-15-70
3

CD WATER WELL DRILLERS LOG

5-15 1970 date well completed
Harris Bros. firm name
Tate county well located

LANDOWNER: James Dean
pt. 2
Caldwater
(mailing address)

description of formations encountered	from	to
top soil	0	20
red sand	20	35
clay	35	60
clay + sand	60	120
coarse sand	120	130

WELL LOCATION:
sec. 32 T 4 N R 6 E 100
3/4 miles W of Praxville
(distance) (direction) (nearest town)

WELL PURPOSE: home
(home, irrigation, municipal, industrial)

WELL COMPLETION DATA:

- (1) diameter (inches) 4
- (2) total depth (feet) 130'
- (3) static water level (feet) 80' below top of ground.
- (4) casing Plastic, 123' (material) (depth)
4" (size) If telescope see back.
- (5) screen 7' 123' (length) (depth to top)
pos. Plastic (size) (material)
- (6) pump 3/4 7 (HP) (yield gpm)
elec. (type power)
- (7) electric log no (yes or no)

(organization running log)

(8) how well bottom plugged brush
shot


DRILLERS REMARKS:

JUN 11 1970

MISS. BD. OF
WATER COMM.

If well telescopes please sketch and show depths.

GROUND LEVEL

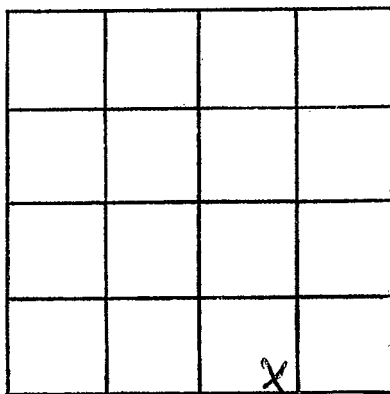

SECTION 32

Please indicate well location X.

ADDITIONAL INFORMATION

If more than one screen,
show locations of each on sketch.