

Tate Co
C 72
7-30-69

MISSISSIPPI
BOARD OF WATER COMMISSIONERS
416 North State Street
Jackson, Mississippi 39201

WATER WELL DRILLERS LOG

July 30 1979 Leake Well Co Tate
date/well completed firm name county well located

LANDOWNER: W.H. Key
Independence Miss

description of formations encountered from to

(mailing address)

WELL LOCATION: 163

sec 35 T 4 R 6
3/4 miles S.E. of Independence
(distance) (direction) (nearest town)

<u>Surfear clay</u>	<u>1</u>	<u>22</u>
<u>Red sand + clay</u>	<u>22</u>	<u>37</u>
<u>Fine White sand + clay</u>	<u>37</u>	<u>80</u>
<u>Med coarse sand</u>	<u>80</u>	<u>112</u>
<u>Coarse White Bearing sand</u>	<u>112</u>	<u>130</u>

WELL PURPOSE: Home
(home, irrigation, municipal, industrial)

WELL COMPLETION DATA:

(1) diameter (inches) 4"
(2) total depth (feet) 130'
(3) static water level (feet) 58 below above top of ground.

(4) casing Plastic, 124'
(material) (depth)

_____ if telescope see back.
(size)

(5) screen 6', 124'
(length) (depth to top)

4"x6" Plastic
(size) (material)

(6) pump 1/2 15
(HP) (yield gpm)

Elec
(type power)

(7) electric log no
(yes or no)

_____ (organization running log)

(8) how well bottom plugged Plastic


DRILLERS REMARKS:

MAY 21 1979

MISS. BD. OF
WATER COM.

If well telescopes please sketch and show depths.

GROUND LEVEL

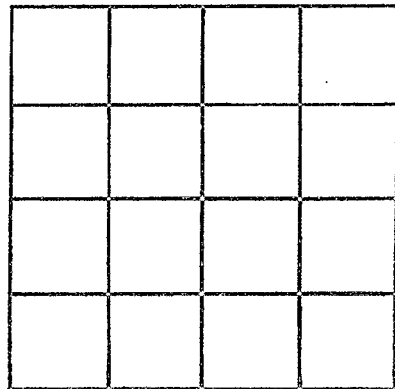

SECTION 38-

Please indicate well location X.

ADDITIONAL INFORMATION

If more than one screen, show locations of each on sketch.