

Tate Co
C 73
5-9-70

MISSISSIPPI
 BOARD OF WATER COMMISSIONERS
 416 North State Street
 Jackson, Mississippi 39201

WATER WELL DRILLERS LOG

5-9-70 1970 Rob Smith Tate
 date well completed firm name county well located


LANDOWNER:	description of formations encountered	from	to
<u>Embrey</u>			
<u>Shelbyplace, Miss</u> (mailing address)	<u>top soil</u>	<u>0</u>	<u>5</u>
	<u>red clay</u>	<u>5</u>	<u>15</u>
	<u>red gravel</u>	<u>15</u>	<u>25</u>
	<u>medium sand</u>	<u>25</u>	<u>140</u>
WELL LOCATION: <u>213</u>			
sec <u>8</u> T <u>4</u> N R <u>6</u> E			
<u>6</u> miles <u>N.W.</u> of <u>Ind</u>			
(distance) (direction) (nearest town)			
WELL PURPOSE: <u>Home</u> (home, irrigation, municipal, industrial)			
WELL COMPLETION DATA:			
(1) diameter (inches) <u>4</u>			
(2) total depth (feet) <u>140</u>			
(3) static water level (feet) <u>80</u> ^{below} _{above} top of ground.			
(4) casing <u>Plastic</u> , <u>140</u> (material) (depth)			
(size) if telescope see back.			
(5) screen <u>20</u> <u>120</u> (length) (depth to top)			
<u>4</u> , <u>Plastic</u> (size) (material)			
(6) pump <u>3/4</u> <u>15</u> (HP) (yield gpm)			
<u>Electric</u> (type power)			
(7) electric log <u>no</u> (yes or no)			
(organization running log)			
(8) how well bottom plugged <u>plugged</u>			
DRILLERS REMARKS:			
<u>good drilling</u>			

MAY 22 1970

MISS. BD. OF
 WATER COMMISSIONERS

If well telescopes please sketch and show depths.

GROUND LEVEL

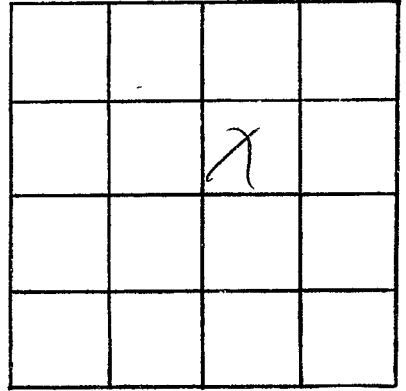

SECTION _____

Please indicate well location X.

ADDITIONAL INFORMATION

If more than one screen, show locations of each on sketch.