

TATE  
 C 75  
 5-20-70

MISSISSIPPI  
 BOARD OF WATER COMMISSIONERS  
 416 North State Street  
 Jackson, Mississippi 39201

**CODED**

WATER WELL DRILLERS LOG

5-20 1970 Harris Bros. Tate  
 date well completed firm name county well located

LANDOWNER: H.C. Huffstatter  
 Rt. 2  
 Caldwellwater  
 (mailing address)

description of formations encountered	from	to
top soil	0	15
clay + sand	15	85
coarse sand	85	100

WELL LOCATION:  
 sec 28 T 4 N R 6 E  
 1 1/2 miles W of Independence  
 (distance) (direction) (nearest town)

WELL PURPOSE: none  
 (home, irrigation, municipal, industrial)

WELL COMPLETION DATA:  
 (1) diameter (inches) 4  
 (2) total depth (feet) 100  
 (3) static water level (feet) 60 below top of ground.  
 (4) casing Plastic, 93' (depth)  
 4 (size) if telescope see back.  
 (5) screen 7' 93" (length) (depth to top)  
 #08 Plastic (size) (material)  
 (6) pump 3/4 10 (HP) (yield gpm)  
 elec. (type power)  
 (7) electric log NO (yes or no)  
 (organization running log)  
 (8) how well bottom plugged brush  
 smuts

**CODED**


NOV 12 1970

MISS. BD. OF  
 WATER COMMISSIONERS

DRILLERS REMARKS:

If well telescopes please sketch and show depths.

GROUND LEVEL

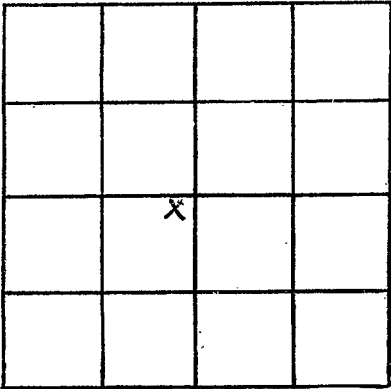

SECTION 28

Please indicate well location X.

ADDITIONAL INFORMATION

If more than one screen, show locations of each on sketch.