

TATE
C 77
6-15-70

MISSISSIPPI
BOARD OF WATER COMMISSIONERS
416 North State Street
Jackson, Mississippi 39201

CODED

WATER WELL DRILLERS LOG

6-15 19 70 Harris Bros. Tate
date well completed firm name county well located

LANDOWNER: Charles Taylor - Rt. 2 Coldwater
(mailing address)

description of formations encountered	from	to
top soil	0	15
red sand	15	45
sand + clay	45	85
coarse sand	85	100

WELL LOCATION:
sec. 35 T 4 N R 6 E
1/2 miles S of Cleburne
(distance) (direction) (nearest town)

WELL PURPOSE: none
(home, irrigation, municipal, industrial)

- WELL COMPLETION DATA:
- (1) diameter (inches) 4
 - (2) total depth (feet) 100
 - (3) static water level (feet) 60 ^{below} top of ground
 - (4) casing Plastic 93'
(material) (depth)
4 (size) If telescope see back.
 - (5) screen 7' 93'
(length) (depth to top)
008 Plastic
(size) (material)
 - (6) pump 3/4 7
(HP) (yield gpm)
elec
(type power)
 - (7) electric log no
(yes or no)
- (organization running log)
- (8) how well bottom plugged back

CODED


NOV 12 1970

MISS. BD. OF
WATER COMM.

DRILLERS REMARKS:

If well telescopes please sketch and show depths.

GROUND LEVEL

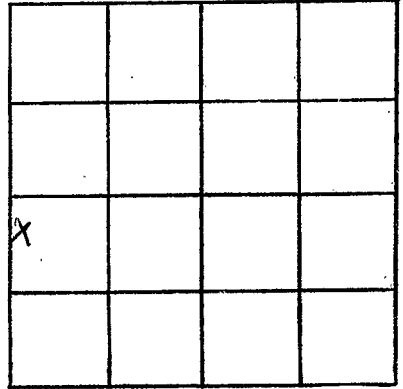

SECTION 35

Please indicate well location X.

ADDITIONAL INFORMATION

If more than one screen, show locations of each on sketch.