

TATE
 C80
 7-8-70

MISSISSIPPI
 BOARD OF WATER COMMISSIONERS
 416 North State Street
 Jackson, Mississippi 39201

CODED

WATER WELL DRILLERS LOG

7-8 1970 Harris Bros. Tate
 date well completed firm name county well located

LANDOWNER: W.C. Hancock
 Independence
 (mailing address)

description of formations encountered	from	to
top soil	0	1.5
red sand	1.5	4.0
clay + sand	4.0	8.5
coarse sand	8.5	10.0

WELL LOCATION:
 sec 26 T 4 N R 6 E W
 in Independence
 (distance) (direction) (nearest town)

WELL PURPOSE: none
 (home, irrigation, municipal, industrial)

- WELL COMPLETION DATA:
- (1) diameter (inches) 4
 - (2) total depth (feet) 100
 - (3) static water level (feet) 60 ^{below} above top of ground
 - (4) casing plastic, 9.3'
 (material) (depth)
 4 (size) if telescope see back.
 - (5) screen 7' 9.3'
 (length) (depth to top)
008 Plastic
 (size) (material)
 - (6) pump 3/4 7
 (HP) (yield gpm)
elec.
 (type power)
 - (7) electric log no
 (yes or no)

CODED

NOV 12 1970


MISS. BD. OF
 WATER COMMISSIONERS

(organization running log)
 (8) how well bottom plugged brush
shot

DRILLERS REMARKS:

If well telescopes please sketch and show depths.

GROUND LEVEL

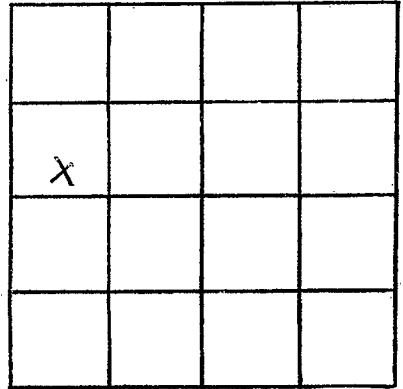

SECTION 26

Please indicate well location X.

ADDITIONAL INFORMATION

If more than one screen,
show locations of each on sketch.