

TATE  
 C81  
 8-10-70

MISSISSIPPI  
 BOARD OF WATER COMMISSIONERS  
 416 North State Street  
 Jackson, Mississippi 39201

**CODED**

WATER WELL DRILLERS LOG

8-10 1970 Harris Bros. Tate  
 date well completed firm name county well located

LANDOWNER: Jimmie Sneed  
 Rt. 3  
 Caldwellwater  
 (mailing address)

description of formations encountered	from	to
top soil	0	15
clay + sand	15	95
course sand	95	110

WELL LOCATION:  
 sec. 17 T. 4 N. R. 6 E.  
 3/4 miles NW of Andersone,  
 (distance) (direction) (nearest town)

WELL PURPOSE: home  
 (home, irrigation, municipal, industrial)

WELL COMPLETION DATA:  
 (1) diameter (inches) 4"  
 (2) total depth (feet) 110  
 (3) static water level (feet) 60 <sup>below</sup> above top of ground.  
 (4) casing Pvc, 10.3  
 (material) (depth).  
4 if telescope see back.  
 (size)  
 (5) screen 7', 10.3  
 (length) (depth to top)  
000 Pvc  
 (size) (material)  
 (6) pump 3/4, 10  
 (HP) (yield gpm)  
ele.  
 (type power)  
 (7) electric log no  
 (yes or no)  
 (organization running log)  
 (8) how well bottom plugged brick  
shot

**CODED**


NOV 12 1970

MISS. Bd. of  
 WATER COMMISSIONERS

DRILLERS REMARKS:

If well telescopes please sketch and show depths.

GROUND LEVEL

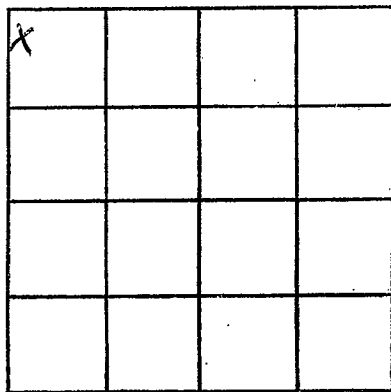

SECTION 17

Please indicate well location X.

ADDITIONAL INFORMATION

If more than one screen, show locations of each on sketch.