

TATE
C82
8-26-70

MISSISSIPPI
BOARD OF WATER COMMISSIONERS
416 North State Street
Jackson, Mississippi 39201

CODED

WATER WELL DRILLERS LOG

8-26-1970 date well completed Bob Smith firm name Tate county well located

LANDOWNER: Roy Hunt
Independence, Miss.
(mailing address)

description of formations encountered	from	to
Top Soil	0	5
red clay	5	40
white sand	40	120

WELL LOCATION:
sec 16 T 4 N R 6 E
5 miles north of Ind
(distance) (direction) (nearest town)

WELL PURPOSE: Home
(home, irrigation, municipal, industrial)

WELL COMPLETION DATA:

(1) diameter (inches) 4

(2) total depth (feet) 120

(3) static water level (feet) 70 below top of ground.

(4) casing Plastic, 120 (material), (depth), (size) if telescope see back.

(5) screen 20, 100 (length), (depth to top)
4, Plastic (size), (material)

(6) pump 1/2, 10 (HP), (yield gpm)
Elec. (type power)

(7) electric log no (yes or no)
(organization running log)

CODED

(8) how well bottom plugged plugged


DRILLERS REMARKS:

DEC 7 1970

MISS. BD. OF
WATER COMM.

If well telescopes please sketch and show depths.

GROUND LEVEL

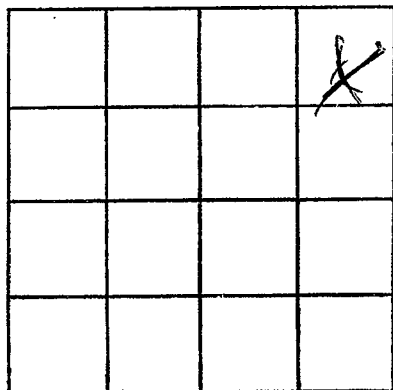

SECTION _____

Please indicate well location X.

ADDITIONAL INFORMATION

If more than one screen,
show locations of each on sketch.