

TATE
 C 83
 11-25-70

MISSISSIPPI
 BOARD OF WATER COMMISSIONERS
 416 North State Street
 Jackson, Mississippi 39201

CODED

WATER WELL DRILLERS LOG

11-25 1970 Bob Smith Tate
 date well completed firm name county well located

LANDOWNER:	description of formations encountered	from	to
<u>Chester Stull</u>			
<u>Andersone, min</u> (mailing address)	<u>top soil</u>	<u>0</u>	<u>5</u>
	<u>red clay</u>	<u>5</u>	<u>40</u>
	<u>white sand</u>	<u>40</u>	<u>120</u>
WELL LOCATION:			
sec. <u>34</u> T. <u>4</u> N R. <u>6</u> E			
<u>2</u> miles <u>S</u> of <u>Tnd.</u>			
(distance) (direction) (nearest town)			
WELL PURPOSE: <u>None</u> (home, irrigation, municipal, industrial)			
WELL COMPLETION DATA:			
(1) diameter (inches) <u>4</u>			
(2) total depth (feet) <u>120</u>			
(3) static water level (feet) <u>110</u> below above top of ground.			
(4) casing <u>Plastic</u> , <u>120</u> (material) (depth)			
<u> </u> (size) if telescope see back.			
(5) screen <u>20</u> , <u>100</u> (length) (depth to top)			
<u>4</u> , <u>Plastic</u> (size) (material)			
(6) pump <u>1/2</u> , <u>10</u> (HP) (yield gpm)			
<u>Electric</u> (type power)			
(7) electric log <u>no</u> (yes or no)			
<u> </u> (organization running log)			
(8) how well bottom plugged <u>plugged</u>			
DRILLERS REMARKS:			


CODED

MAR 1 1971

ENGS. BD. OF
 WATER COM.

If well telescopes please sketch and show depths.

GROUND LEVEL

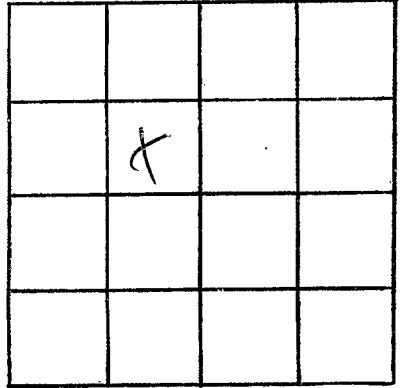

SECTION _____

Please indicate well location X.

ADDITIONAL INFORMATION

If more than one screen, show locations of each on sketch.