

TATE  
C84  
9-24-71

MISSISSIPPI  
BOARD OF WATER COMMISSIONERS  
416 North State Street  
Jackson, Mississippi 39201

WATER WELL DRILLERS LOG

**CODED**

9-24-71 date well completed      Bob Smith firm name      Tate county well located

LANDOWNER: James Hollier  
Udypah, Miss.  
(mailing address)

WELL LOCATION: SWNE  
sec 5 T 4 N R 6 E  
7 miles North of IND.  
(distance) (direction) (nearest town)

WELL PURPOSE: None  
(home, irrigation, municipal, industrial)

description of formations encountered	from	to
<u>Top soil</u>	<u>0</u>	<u>5</u>
<u>red clay</u>	<u>5</u>	<u>15</u>
<u>red sand</u>	<u>15</u>	<u>30</u>
<u>red gravel</u>	<u>30</u>	<u>50</u>
<u>white sand</u>	<u>50</u>	<u>200</u>

WELL COMPLETION DATA:

(1) diameter (inches) 4

(2) total depth (feet) 200

(3) static water level (feet) 110 below above top of ground.

(4) casing Plastic, 200  
(material), (depth)  
(size) If telescope see back.

(5) screen 20, 180  
(length), (depth to top)  
4, Plastic  
(size), (material)

(6) pump 1/2, 10  
(HP), (yield gpm)  
Elek  
(type power)

(7) electric log no  
(yes or no)  
(organization running log)

(8) how well bottom plugged plugged

**CODED**


NOV 22 1971

MISS. BD. OF  
WATER COMMISSIONERS

DRILLERS REMARKS:

If well telescopes please sketch and show depths.

GROUND LEVEL

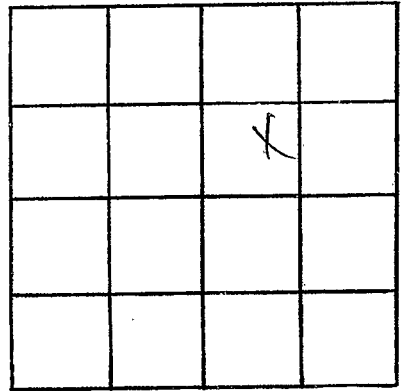

SECTION \_\_\_\_\_

Please indicate well location X.

ADDITIONAL INFORMATION

If more than one screen, show locations of each on sketch.