

Tate
C85
5-10-71

MISSISSIPPI
 BOARD OF WATER COMMISSIONERS
 416 North State Street
 Jackson, Mississippi 39201

DEC 8 1971

CODED

WATER WELL DRILLERS LOG

5-10 1971 Harris Bros. Tate
 date well completed firm name county well located

LANDOWNER: D.E. Fullerton
pt. 2
Caldwater
 (mailing address)

description of formations encountered	from	to
<u>top soil</u>	<u>0</u>	<u>20</u>
<u>gray clay</u>	<u>20</u>	<u>120</u>
<u>Coarse sand</u>	<u>120</u>	<u>130</u>

WELL LOCATION:
 sec 25 T 4 N R 6 E
1 miles E Independence
 (distance) (direction) of (nearest town)

WELL PURPOSE: home
 (home, irrigation, municipal, industrial)


- WELL COMPLETION DATA:
- (1) diameter (inches) 4
 - (2) total depth (feet) 130
 - (3) static water level (feet) 80 below above top of ground.
 - (4) casing plastic, 123
 (material) (depth)
4 If telescope see back.
 (size)
 - (5) screen 7, 123
 (length) (depth to top)
008 Plastic
 (size) (material)
 - (6) pump 3/4 10
 (HP) (yield gpm)
elec.
 (type power)
 - (7) electric log no
 (yes or no)
 - (organization running log)
 - (8) how well bottom plugged back
short

CODED

DRILLERS REMARKS:

If well telescopes please sketch and show depths.

GROUND LEVEL

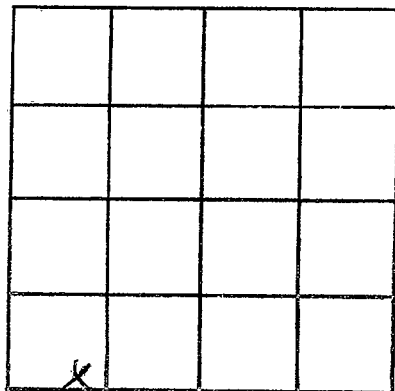

SECTION 25

Please indicate well location X.

ADDITIONAL INFORMATION

If more than one screen,
show locations of each on sketch.