

TATE
C 88
7-10-71

MISSISSIPPI
BOARD OF WATER COMMISSIONERS
416 North State Street
Jackson, Mississippi 39201

DEC 1971
CODED
MISS. BOARD OF WATER COMMISSIONERS

WATER WELL DRILLERS LOG

WATER
TATE


7-10 1971 date well completed
Harris Bros. firm name
Tate county well located

LANDOWNER: <u>Percy Ferguson</u>	description of formations encountered	from	to
<u>Rt. 2</u> <u>Caldwater</u> (mailing address)			
WELL LOCATION: sec <u>35</u> T <u>4</u> N R <u>6</u> E <u>1/2</u> miles <u>in independence</u> of (nearest town)	<u>top soil</u>	<u>0</u>	<u>15</u>
	<u>red sand</u>	<u>15</u>	<u>35</u>
	<u>sand + clay</u>	<u>35</u>	<u>85</u>
	<u>Coarse sand</u>	<u>85</u>	<u>100</u>
WELL PURPOSE: <u>home</u> (home, irrigation, municipal, industrial)			
WELL COMPLETION DATA: (1) diameter (inches) <u>4</u>			
(2) total depth (feet) <u>100</u>			
(3) static water level (feet) <u>60</u> <u>below</u> above top of ground.			
(4) casing <u>Plastic</u> <u>93</u> (material) (depth)			
<u>4</u> (size) if telescope see back.			
(5) screen <u>7'</u> <u>93</u> (length) (depth to top)			
<u>008</u> <u>Plastic</u> (size) (material)			
(6) pump <u>3/4</u> <u>7</u> (HP) (yield gpm)			
<u>elec.</u> (type power)			
(7) electric log <u>no</u> (yes or no)			
(organization running log)			
(8) how well bottom plugged <u>back</u> <u>shot</u>			
DRILLERS REMARKS:			

CODED

If well telescopes please sketch and show depths.

GROUND LEVEL

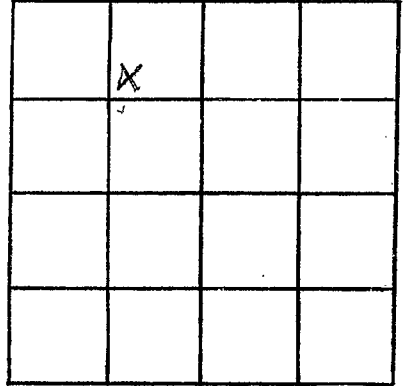

SECTION 25

Please indicate well location X.

ADDITIONAL INFORMATION

If more than one screen, show locations of each on sketch.