

TATE
C 89
7-10-71

MISSISSIPPI
BOARD OF WATER COMMISSIONERS DEC 8 1971

416 North State Street
Jackson, Mississippi 39201

CODED

WATER WELL DRILLERS LOG

Tate

7-10
date well completed

71 Harris Bros.
firm name

county well located

LANDOWNER: Webber Sewell

description of formations encountered

from

to

Rt 23

top soil

0 20

Coldwater

sand + clay

20 120

(mailing address)

WELL LOCATION:

coarse sand

120 130

sec 24 T 4 N 6 E
1 1/2 miles NE of Independence
(distance) (direction) (nearest town)

WELL PURPOSE: none
(home, irrigation, municipal, industrial)

WELL COMPLETION DATA:

CODED

- (1) diameter (inches) 4
- (2) total depth (feet) 130
- (3) static water level (feet) 80 ^{below} _{above} top of ground.
- (4) casing Plastic, 123
(material) (depth)
- 4
(size) if telescope see back.
- (5) screen 7, 123
(length) (depth to top)
- 008, Plastic
(size) (material)
- (6) pump 3/4, 7
(HP) (yfeld gpm)
- elec.
(type power)
- (7) electric log no
(yes or no)


(organization running log)

(8) how well bottom plugged wick
shot

DRILLERS REMARKS:

If well telescopes please sketch and show depths.

GROUND LEVEL

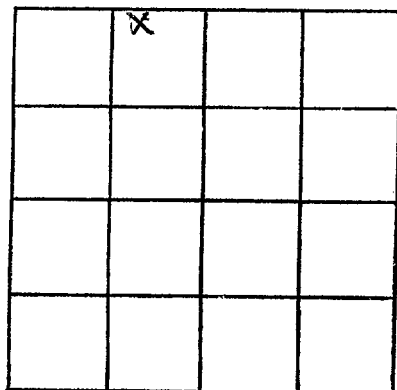

SECTION 24

Please indicate well location X.

ADDITIONAL INFORMATION

If more than one screen, show locations of each on sketch.