

TATE
C91
8-25-71

MISSISSIPPI
BOARD OF WATER COMMISSIONERS
416 North State Street
Jackson, Mississippi 39201

DEC 8 1971

WATER WELL DRILLERS LOG

STATE OF MISSISSIPPI
DEPARTMENT OF AGRICULTURE
CODED


8-25-71 date well completed 1971 firm name Harris Bros. county well located Fulton

LANDOWNER:	description of formations encountered	from	to
<u>R.E. Coleman</u>			
<u>Rt. 2</u>	<u>top soil</u>	<u>0</u>	<u>15</u>
<u>Coldwater</u> (mailing address)	<u>clayt sand</u>	<u>15</u>	<u>115</u>
WELL LOCATION: sec. <u>34</u> T <u>4</u> N R. <u>6</u> E <u>1</u> miles S of <u>Independence</u> (distance) (direction) (nearest town)	<u>Coarse sand</u>	<u>115</u>	<u>130</u>
WELL PURPOSE: (home, irrigation, municipal, industrial)			
WELL COMPLETION DATA: (1) diameter (inches) <u>4</u> (2) total depth (feet) <u>130</u> (3) static water level (feet) <u>80</u> <u>below</u> top of ground. (4) casing <u>Plastic</u> , <u>123</u> (material) (depth) <u>4</u> (size) if telescope see back. (5) screen <u>7</u> (length), <u>123</u> (depth to top) <u>008, Plastic</u> (size) (material) (6) pump <u>3/4</u> (HP), <u>7</u> (yield gpm) <u>elec.</u> (type power) (7) electric log <u>no</u> (yes or no) (organization running log) (8) how well bottom plugged <u>brick</u> <u>shot</u>			
DRILLERS REMARKS:			

CODED

If well telescopes please sketch and show depths.

GROUND LEVEL

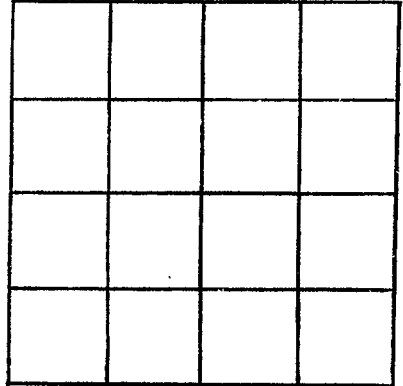

SECTION _____

Please indicate well location X.

ADDITIONAL INFORMATION

If more than one screen,
show locations of each on sketch.