

TATE
C 93
9-13-71

MISSISSIPPI
BOARD OF WATER COMMISSIONERS
416 North State Street
Jackson, Mississippi 39201

DEC 8 1971

MISS. BD. OF
WATER

WATER WELL DRILLERS LOG

CODED

9-13 1971 date well completed
Harris Bros. firm name
county well located

| LANDOWNER: <u>Murton Crockett</u> | description of formations encountered | from | to |
|---|---------------------------------------|------------|------------|
| <u>RT. 3</u> <u>Caldwater</u> (mailing address) | | | |
| | <u>top soil</u> | <u>0</u> | <u>20</u> |
| | <u>clay + sand</u> | <u>20</u> | <u>100</u> |
| | <u>clay</u> | <u>100</u> | <u>150</u> |
| | <u>Coarse sand</u> | <u>150</u> | <u>170</u> |

WELL LOCATION:

sec 22 T 4 N R 6 E
1 1/2 miles N of Independence
(distance) (direction) (nearest town)

WELL PURPOSE: name
(home, irrigation, municipal, industrial)

WELL COMPLETION DATA:

- (1) diameter (inches) 4
- (2) total depth (feet) 170
- (3) static water level (feet) 100 below top of ground
- (4) casing Plastic, 156
(material) (depth)
4 if telescope see back.
(size)
- (5) screen 14, 156
(length) (depth to top)
008, Plastic
(size) (material)
- (6) pump 3/4, 10
(HP) (field gpm)
elec.
(type power)
- (7) electric log no
(yes or no)

CODED


(organization running log)

(8) how well bottom plugged back

DRILLERS REMARKS:

If well telescopes please sketch and show depths.

GROUND LEVEL

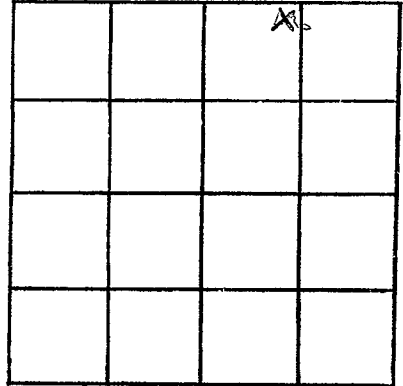

SECTION 22

Please indicate well location X.

ADDITIONAL INFORMATION

If more than one screen,
show locations of each on sketch.