

TATE
C94
10-6-71

MISSISSIPPI
BOARD OF WATER COMMISSIONERS
416 North State Street
Jackson, Mississippi 39201

DEC 8 1971

RECORDED & INDEXED
CODED

WATER WELL DRILLERS LOG

Tate

10-6
date well completed

1971

Harris Bros.
firm name

county well located.

LANDOWNER: W. L. Hudson

pt. 3

Coldwater

(mailing address)

description of formations encountered

from

to

top soil

0

15

red sand

15

40

white clay

40

65

clay sand

65

125

course sand

125

140

WELL LOCATION:

sec. 15 T 4 N R. 6 E
1 1/2 miles N of Independence
(distance) (direction) (nearest town)

WELL PURPOSE:

(home, irrigation, municipal, industrial)

WELL COMPLETION DATA:

- (1) diameter (inches) 4
- (2) total depth (feet) 140
- (3) static water level (feet) 20 ^{below} above top of ground.
- (4) casing plastic, 133
(material) (depth)
- 4
(size) if telescope see back.
- (5) screen 7, 133
(length) (depth to top)
- 008, plastic
(size) (material)
- (6) pump 3/4, 10
(HP) (yield gpm)
- elec.
(type power)
- (7) electric log no
(yes or no)

(organization running log)


- (8) how well bottom plugged back
shot

DRILLERS REMARKS:

CODED

If well telescopes please sketch and show depths.

GROUND LEVEL

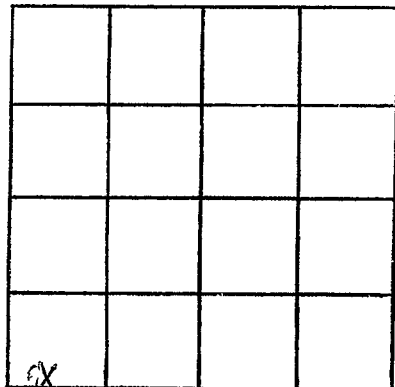

SECTION LS

Please indicate well location X.

ADDITIONAL INFORMATION

If more than one screen, show locations of each on sketch.