

TATE
C 95
10-10-71

MISSISSIPPI
BOARD OF WATER COMMISSIONERS
416 North State Street
Jackson, Mississippi 39201

DEC 2 1971
CODED
-WATER-


WATER WELL DRILLERS LOG

10-10-71 date well completed Harris Bros. firm name Tate county well located

LANDOWNER: <u>Billy Key</u>	description of formations encountered	from	to
<u>Pt. 2</u> <u>Coldwater</u> (mailing address)	<u>top soil</u>	<u>0</u>	<u>15</u>
WELL LOCATION: sec. <u>35</u> T <u>4</u> N R. <u>6</u> E <u>1/2</u> miles S of <u>Independence</u> (distance) (direction) (nearest town)	<u>red sand</u>	<u>15</u>	<u>40</u>
WELL PURPOSE: <u>home</u> (home, irrigation, municipal, industrial)	<u>clay + sand</u>	<u>40</u>	<u>110</u>
WELL COMPLETION DATA:	<u>coarse sand</u>	<u>110</u>	<u>120</u>
(1) diameter (inches) <u>4</u>	CODED		
(2) total depth (feet) <u>120</u>			
(3) static water level (feet) <u>80</u> ^{below} above top of ground.			
(4) casing <u>plastic</u> , <u>113</u> (material) (depth)			
<u>4</u> (size) if telescope see back.			
(5) screen <u>7'</u> , <u>113</u> (length) (depth to top)			
<u>008 plastic</u> (size) (material)			
(6) pump <u>3/4</u> <u>10</u> (HP) (yield gpm)			
<u>elec.</u> (type power)			
(7) electric log <u>no</u> (yes or no)			
(organization running log)			
(8) how well bottom plugged <u>back</u> <u>shot</u>			
DRILLERS REMARKS:			

If well telescopes please sketch and show depths.

GROUND LEVEL

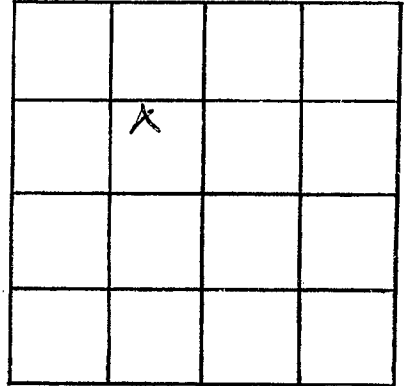

SECTION 35

Please indicate well location X.

ADDITIONAL INFORMATION

If more than one screen,
show locations of each on sketch.