

TATE
C 98
4-23-72

MISSISSIPPI
BOARD OF WATER COMMISSIONERS
416 North State Street
Jackson, Mississippi 39201

WATER WELL DRILLERS LOG

4-23-72 date well completed 1972 Nicholson Well Co. firm name TATE county well located

LANDOWNER:
Roy Clark
RT-2 Coldwater Miss
(mailing address)

description of formations encountered	from	to
Top Soil	0	15
Red Sand	15	40
Fine Sand	40	60
Course Sand	60	85

WELL LOCATION:
sec. 27 T 4 N R 6 E
3 miles west of Independence
(distance) (direction) (nearest town)

WELL PURPOSE: Home & Farm
(home, irrigation, municipal, industrial)

WELL COMPLETION DATA:
(1) diameter (inches) 4"
(2) total depth (feet) 85'
(3) static water level (feet) 44' below top of ground.
(4) casing: pvc, 75' (material) (depth)

(size) if telescope see back.
(5) screen 10' 75' (length) (depth to top)
4" pvc (size) (material)

(6) pump 3/4 HP 12 (yield gpm)
220 (type power)

(7) electric log No (yes or no)

(organization running log)

(8) how well bottom plugged Solid

DRILLERS REMARKS:


CODED

APR 26 1972

MISS. SD. GE
WATER CO. 12

If well telescopes please
sketch and show depths.

GROUND LEVEL

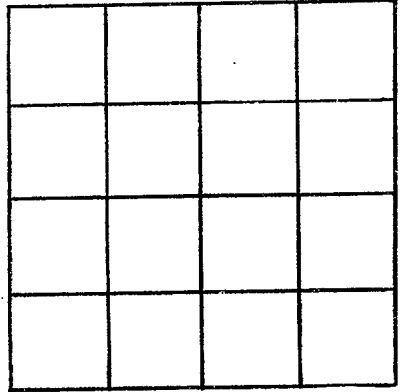

SECTION _____

Please indicate well location X.

ADDITIONAL INFORMATION

If more than one screen,
show locations of each on sketch.