

Tate
C.100
4-26-72

MISSISSIPPI
 BOARD OF WATER COMMISSIONERS
 416 North State Street
 Jackson, Mississippi 39201

CODED

WATER WELL DRILLERS LOG

4-26 1972 G. & H. Well Co TATE
 date well completed firm name county well located

LANDOWNER: J. E. Bowden
INDEPENDANCE, MISS

description of formations encountered	from	to
<u>SANDY CLAY</u>	<u>0</u>	<u>30</u>
<u>Red SAND</u>	<u>30</u>	<u>45</u>
<u>White SAND</u>	<u>45</u>	<u>110</u>

(mailing address)

WELL LOCATION:
 sec. 35 T 4 N R 6 E
 (distance) miles 1 (direction) EAST of INDEPENDANCE (nearest town)

WELL PURPOSE:
 (home, irrigation, municipal, industrial)

WELL COMPLETION DATA:

- (1) diameter (inches) 4"
- (2) total depth (feet) 110
- (3) static water level (feet) 59 below above-top of ground.
- (4) casing PLASTIC, 105
 (material) (depth)
— if telescope see back.
 (size)
- (5) screen 5', 105'
 (length) (depth to top)
4", GRAVEL-TYPE PLASTIC
 (size) (material)
- (6) pump 3/4, 10
 (HP) (yield gpm)
220 E10C
 (type power)
- (7) electric log NO
 (yes or no)
—
 (organization running log)
- (8) how well bottom plugged CAP

CODED


MAY 1 - 1972

DRILLERS REMARKS:

MISS. BD. OF
 WATER COMMISSIONERS

If well telescopes please sketch and show depths.

GROUND LEVEL

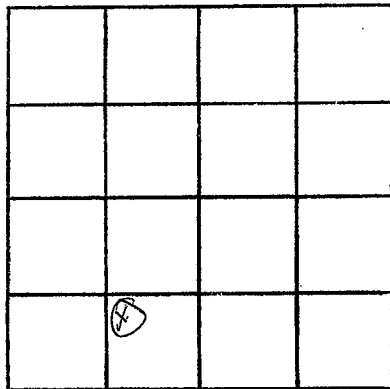

SECTION _____

Please indicate well location X.

ADDITIONAL INFORMATION

If more than one screen,
show locations of each on sketch.