

TATE
C 106
2-22-72

MISSISSIPPI
 BOARD OF WATER COMMISSIONERS
 416 North State Street
 Jackson, Mississippi 39201

CODED

WATER WELL DRILLERS LOG

2-22
 date well completed

1972 Harris Bros.
 firm name

Tate
 county well located

LANDOWNER: H. S. Roberts

Rt. 2
Coldwater
 (mailing address)

description of formations encountered

from

to

| | | |
|--------------------|-----------|------------|
| <u>top soil</u> | <u>0</u> | <u>15</u> |
| <u>clay + sand</u> | <u>15</u> | <u>85</u> |
| <u>coarse sand</u> | <u>85</u> | <u>100</u> |

WELL LOCATION:

sec 27 T 4 N 6 E
1/2 miles W of Independence
 (distance) (direction) (nearest town)

WELL PURPOSE: None
 (home, irrigation, municipal, industrial)

WELL COMPLETION DATA:

- (1) diameter (inches) 4
- (2) total depth (feet) 100
- (3) static water level (feet) 60 below above top of ground.
- (4) casing Plastic, 93
 (material) (depth)
4 if telescope see back.
 (size)
- (5) screen 7, 93
 (length) (depth to top)
008, Plastic
 (size) (material)
- (6) pump 3/4, 7
 (HP) (yield gpm)
elec.
 (type power)
- (7) electric log no
 (yes or no)

(organization running log)

(8) how well bottom plugged Solid

CODED


ONE - 7 1972

DRILLERS REMARKS:

MISS. B. O.
 WATER COMMISSIONERS

If well telescopes please sketch and show depths.

GROUND LEVEL

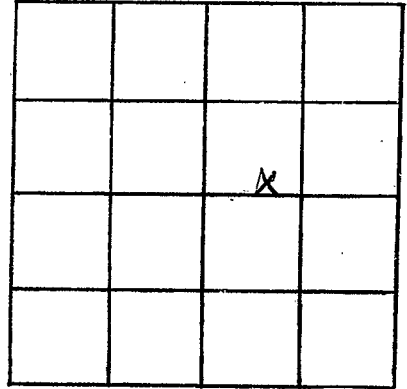

SECTION 27

Please indicate well location X.

ADDITIONAL INFORMATION

A series of horizontal lines for writing additional information.

If more than one screen, show locations of each on sketch.