

TATE
C 107
5-8-72

MISSISSIPPI
BOARD OF WATER COMMISSIONERS
416 North State Street
Jackson, Mississippi 39201

CODED

WATER WELL DRILLERS LOG

5-8 1972 Harris Bros. Tate
date well completed firm name county well located

LANDOWNER: <u>Allen Kern</u>	description of formations encountered	from	to
<u>Rt. 2</u> <u>Coldwater</u> (mailing address)			
WELL LOCATION: sec. <u>3</u> T <u>4</u> N R <u>6</u> E <u>5</u> miles <u>NW</u> of <u>Independence</u> (distance) (direction) (nearest town)	<u>top soil</u>	<u>0</u>	<u>15</u>
WELL PURPOSE: <u>Municipal</u> (home, irrigation, municipal, industrial) <u>SUBDIVISION</u>	<u>sand + pea gravel</u>	<u>15</u>	<u>25</u>
WELL COMPLETION DATA: (1) diameter (inches) <u>4</u>	<u>white clay</u>	<u>25</u>	<u>40</u>
(2) total depth (feet) <u>190</u>	<u>clay and sand mix</u>	<u>40</u>	<u>120</u>
(3) static water level (feet) <u>100</u> <u>below</u> top of ground. <u>above</u>	<u>fine white sand</u>	<u>120</u>	<u>150</u>
(4) casing <u>Plastic</u> <u>160</u> (material) (depth)	<u>coarse white sand</u>	<u>150</u>	<u>190</u>
<u>4</u> if telescope see back. (size)			
(5) screen <u>30'</u> <u>160</u> (length) (depth to top)			
<u>008</u> <u>Plastic</u> (size) (material)			
(6) pump <u>5</u> <u>97</u> (HP) (yield gpm)			
<u>Elec.</u> (type power)			
(7) electric log <u>no</u> (yes or no)			
(organization running log)			
(8) how well bottom plugged <u>fluid</u>			

CODED


AUG 7 1972

MISS. BD. OF
WATER COMMISSIONERS

DRILLERS REMARKS: Exterior
space around casing
filled from 190' to
140' with silica then cement grout to top

If well telescopes please sketch and show depths.

GROUND LEVEL

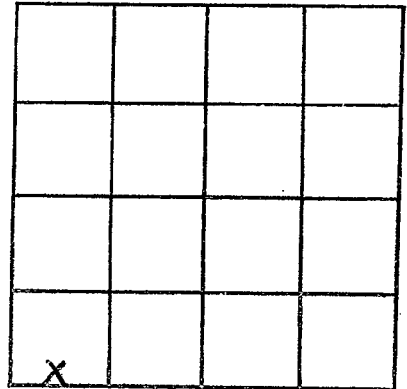

SECTION 3

Please indicate well location X.

ADDITIONAL INFORMATION

If more than one screen,
show locations of each on sketch.