

TATE  
C 108  
2-20-72

MISSISSIPPI  
BOARD OF WATER COMMISSIONERS  
416 North State Street  
Jackson, Mississippi 39201

**CODED**

WATER WELL DRILLERS LOG

2-20 1972 date well completed      Harris Bros. firm name      Tate county well located

LANDOWNER: <u>Edward R. Hayes Jr.</u>	description of formations encountered	from	to
<u> Rt. 2 Coldwater </u> (mailing address)			
WELL LOCATION: sec. <u> 27 </u> T <u> 4 </u> N R <u> 6 </u> E <u> 1/2 </u> miles <u> W </u> of <u> Independence </u> (distance) (direction) (nearest town)	<u> clay + sand </u>	<u> 15 </u>	<u> 85 </u>
WELL PURPOSE: <u> home </u> (home, irrigation, municipal, industrial)	<u> coarse sand </u>	<u> 85 </u>	<u> 100 </u>
WELL COMPLETION DATA: (1) diameter (inches) <u> 4 </u>			
(2) total depth (feet) <u> 100 </u>			
(3) static water level (feet) <u> 60 </u> <u> below </u> top of ground.			
(4) casing <u> Plastic </u> , <u> 93' </u> (material) (depth)			
<u> 008 </u> if telescope see back. (size)			
(5) screen <u> 7' </u> , <u> 93 </u> (length) (depth to top)			
<u> 008 Plastic </u> (size) (material)			
(6) pump <u> 3/4 </u> , <u> 10 </u> (HP) (yield gpm)			
<u> elec. </u> (type power)			
(7) electric log <u> no </u> (yes or no)			
(organization running log)			
(8) how well bottom plugged <u> Solid </u>			
DRILLERS REMARKS:			


**CODED**

AUG - 7 1972

MISS. RD. OF  
WATER COMM.

If well telescopes please sketch and show depths.

GROUND LEVEL

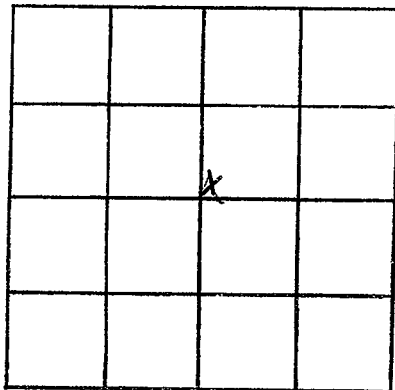

SECTION 27

Please indicate well location X.

ADDITIONAL INFORMATION

If more than one screen, show locations of each on sketch.