

TATE

C109

4-29-72

BOARD OF WATER COMMISSIONERS

416 North State Street

Jackson, Mississippi 39201

WATER WELL DRILLERS LOG

CODED

4-29

1972

Harris Bros.

Tate

date well completed

firm name

county well located

LANDOWNER: Benny Steaks

description of formations encountered

from

to

Rt. 2

Coldwater

(mailing address)

top soil

0

20

sand + clay

20

80

WELL LOCATION:

sec. 33 T. 4 N. R. 6 E. of Popville
1 1/2 miles (distance) E (direction) (nearest town)

fine sand

80

125

Coarse sand

125

140

WELL PURPOSE: none
(home, irrigation, municipal, industrial)

CODED

WELL COMPLETION DATA:

- (1) diameter (inches) 4
- (2) total depth (feet) 140
- (3) static water level (feet) 80 ^{below}/_{above} top of ground.
- (4) casing Plastic, 133'
(material) (depth)
4 if telescope see back.
(size)
- (5) screen 7, 133
(length) (depth to top)
008, Plastic
(size) (material)
- (6) pump 3/4 10
(HP) (yield gpm)
elec
(type power)
- (7) electric log no
(yes or no)
- (organization running log)
- (8) how well bottom plugged solid


NOV 18 1972

DRILLERS REMARKS:

MISS. DE. OF
WATER RESOURCES

If well telescopes please sketch and show depths.

GROUND LEVEL

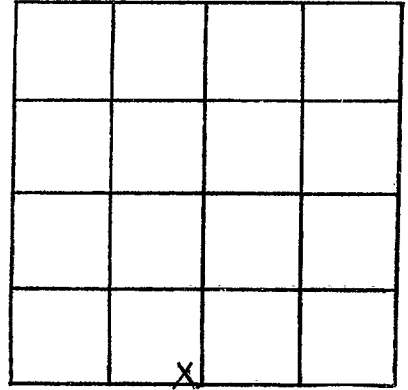

SECTION 34

Please indicate well location X.

ADDITIONAL INFORMATION

If more than one screen,
show locations of each on sketch.