

MISSISSIPPI
BOARD OF WATER COMMISSIONERS
416 North State Street
Jackson, Mississippi 39201

WATER WELL DRILLERS LOG

CODED

TATE
C 111
4-10-72

4-10-1972 date well completed Harris Bros. Tate firm name county well located

LANDOWNER: David Ashford
Rt. 3
Coldwater
(mailing address)

description of formations encountered	from	to
top soil	0	15
red sand	15	35
clay & sand	35	125
coarse sand	125	140

WELL LOCATION:
sec. 12 T 4 N R 6 E
1 1/2 miles N of New Garden
(distance) (direction) (nearest town)

WELL PURPOSE: home
(home, irrigation, municipal, industrial)

- WELL COMPLETION DATA:
- (1) diameter (inches) 4
 - (2) total depth (feet) 140
 - (3) static water level (feet) 80 below above top of ground.
 - (4) casing Plastic, 133 (material) (depth)
4 (size) if telescope see back.
 - (5) screen 7' 133' (length) (depth to top)
208 Plastic (size) (material)
 - (6) pump 3/4 7 (HP) (yield gpm)
sleeve (type power)
 - (7) electric log no (yes or no)
(organization running log)
 - (8) how well bottom plugged solid

CODED


OCT 18 1972

DRILLERS REMARKS:

MISS. BD. OF
WATER COMMISSIONERS

If well telescopes please sketch and show depths.

GROUND LEVEL

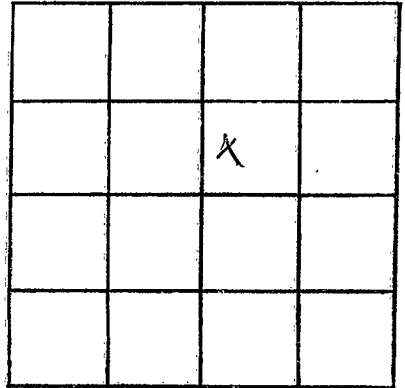

SECTION 12

Please indicate well location X.

ADDITIONAL INFORMATION

If more than one screen, show locations of each on sketch.